



STATE OF NORTH CAROLINA  
DEPARTMENT OF TRANSPORTATION

MICHAEL F. EASLEY  
GOVERNOR

LYNDO TIPPETT  
SECRETARY

July 14, 2003

**Addendum No. 1**

RE: Contract ID: C200692 (Proposal No.1)  
Work Order No. 8.U401717  
F. A. No. NHF-540 (1)  
Wake County (R-2000G)  
I-540 (Northern Wake Expressway) From South of  
SR-2215 (Buffaloe Road) To US-64 East of Knightdale.

**July 22, 2003 Special Letting**

To Whom It May Concern:

Reference is made to the plans and proposal form furnished to you on the above-mentioned project.

The following revisions have been made to the plans:

Roadway typical sheet nos. 2-A and 2-B have been revised to correct the limits of concrete paving on the ramps. Please void sheet nos. 2-A and 2-B in your plans and staple the revised sheet nos. 2-A and 2-B thereto.

Sheet nos. S-35, S-37, S-69, and S-71 of the structure plans have been revised to show a work bridge instead of a workpad for temporary access. Please void sheet nos. S-35, S-37, S-69 and S-71 in your plans and staple the revised sheet nos. S-35, S-37, S-69 and S-71 thereto.

Sheet nos. S-105, S-107 and S-108 of the structure plans have been revised to show temporary shoring and to indicate no traffic on stage 1 bridge construction. Please void sheet nos. S-105, S-107 and S-108 in your plans and staple the revised sheet nos. S-105, S-107 and S-108 thereto.

The following revisions have been made to the proposal form:

Page No. 432 has been revised to show the location of wetland sites no. 13 and 14. Please void Page No. 432 in your proposal and staple the revised Page No. 432 thereto.

New Page Nos. 432-A, 432-B and 432-C and are being added to include wetland sites No. 13 and 14. Please add new Page Nos. 432-A, 432-B and 432-C after revised Page No. 432. Page No. 473 has been revised to include sites 13 and 14. Please void Page no. 473 in your proposal and staple the revised Page No. 473 thereto.

Page No. 458, labeled "Workpad Detail" is obsolete. Please void Page No. 458 in your proposal and staple the revised Page No. 458 (Intentionally Blank) thereto.


By copy of this addendum, the quantities for the following pay items shown on Page No. 3 and 4 of the item sheets are hereby revised:

<u>Line Item &amp; Description</u>	<u>Old Quantity</u>	<u>New Quantity</u>
51-1121000000-M-520 Aggregate Base Course	38,100MTN	35,900MTN
56-1489000000-M-610 Asphalt Conc. Base Course, Type B25.0B	26,900MTN	26,925MTN
59-1503000000-M-610 Asphalt Conc. Inter. Course, Type I19.0C	20,100MTN	16,780MTN
60-1519000000-M-610 Asphalt Conc. Surface Course, Type S9.5B	11,775MTN	11,920MTN
61-1539000000-M-610 Asphalt Conc. Surface Course, Type S12.5C	12,750MTN	12,145MTN
62-1560000000-M-620 Asphalt Binder For Plant Mix, Grade PG-64-22	3,760MTN	3,694MTN
63-1565000000-M-620 Asphalt Binder For Plant Mix, Grade PG-70-22	705MTN	669MTN
65-187470000000-M-710 300MM Port. Cem. Conc. Pavement through Lanes (with Dowels)	131,090M2	131,500M2
66-186900000000-M-710 300MM Port. Cem. Conc. Pavement Miscellaneous (without Dowels)	6,810M2	4,350M2
68-1913000000-M-720 Concrete Shoulders Adjacent to 300MM Pavement	70,430M2	72,975M2

The Contractor's bid prices should be based on these revised pay item quantities. By copy of this addendum, the following lump sum pay item on Page 20 of the item sheets, is hereby deleted: "328-8017000000-N-SP Construction, Maintenance, & Removal of Temporary Access at Sta. 445 + 88.000-L-RT-". All cost for the temporary access at this location should be included in the pay item for the left lane. The contract will be prepared accordingly.

The Expedite file has been updated to reflect these revisions. Please download the EBS addendum file and follow the instructions for applying the addendum. Bid Express will not accept your bid unless all addendums have been applied.

Sincerely,

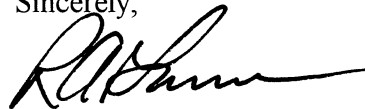


R. A. Garriss, P.E.  
Contract Officer


RAG/jag/pa

Attachments


Cc: Mr. J. D. Goins, P.E.  
Mr. S. D. DeWitt, P.E.  
Mr. J. G. Nance, P.E.  
Ms. D. M. Barbour, P.E.  
Mr. J. V. Barbour, P.E.  
Mr. Scott Blevins, P.E.  
Mr. J. F. Sullivan, III (FHWA)  
Mr. Mark Staley (2)  
Mr. Aydren Flowers  
Mr. Ron Davenport, Jr., P.E.  
Ms. Kim Canady  
Ms. Yang Steelman  
Project File (2)

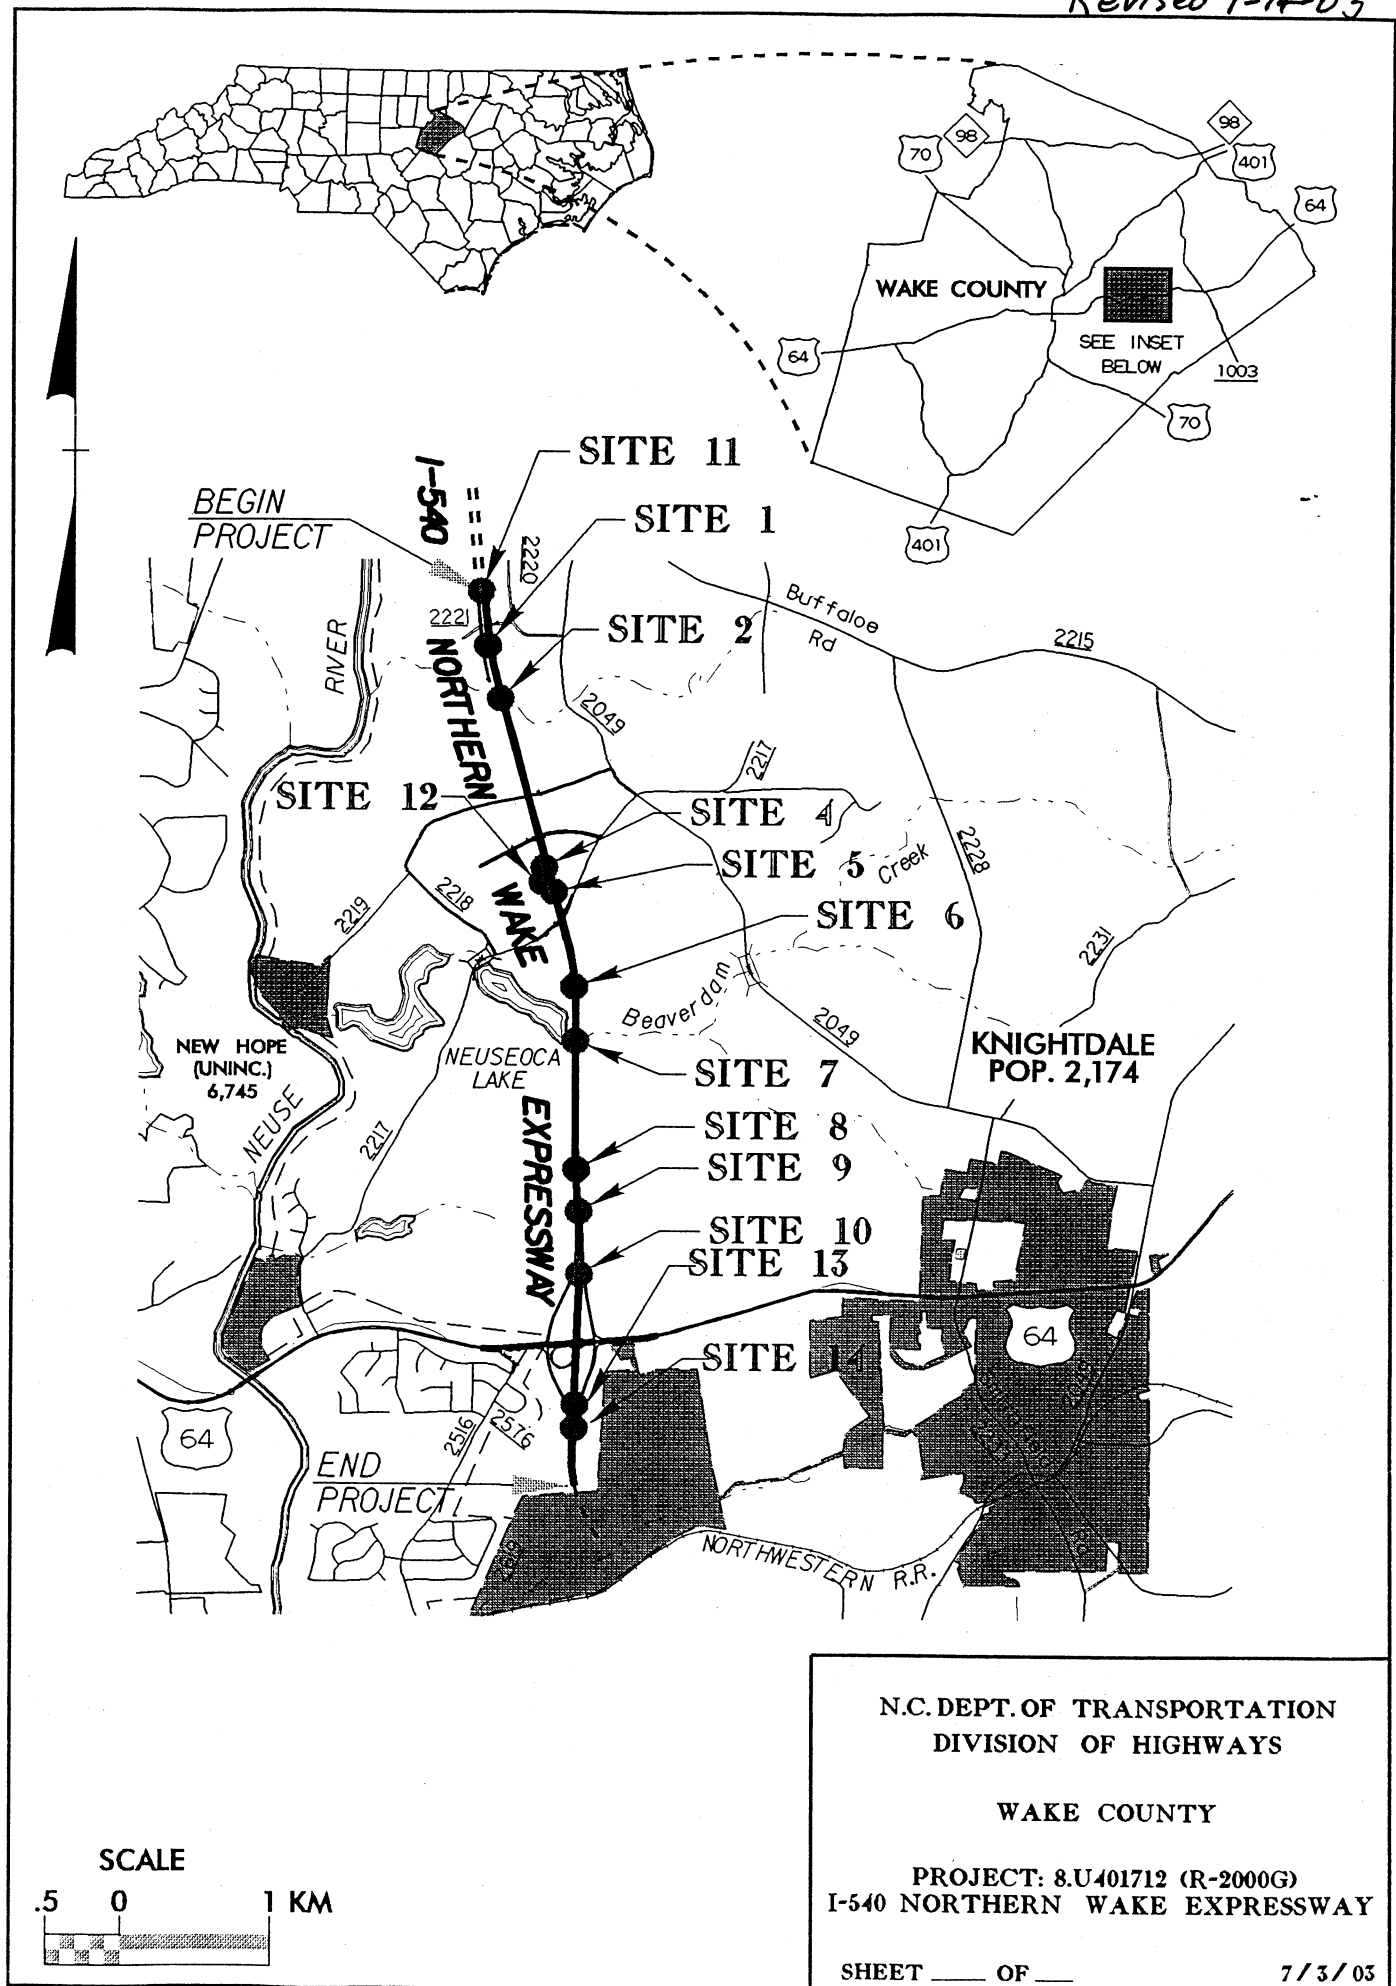

N.C. DEPT. OF TRANSPORTATION  
DIVISION OF HIGHWAYS  
WAKE COUNTY  
PROJECT: 8U401712 (R-2000G)  
I-540 NORTHERN WAKE EXPRESSWAY  
SHEET 3 OF 3 7/3/03

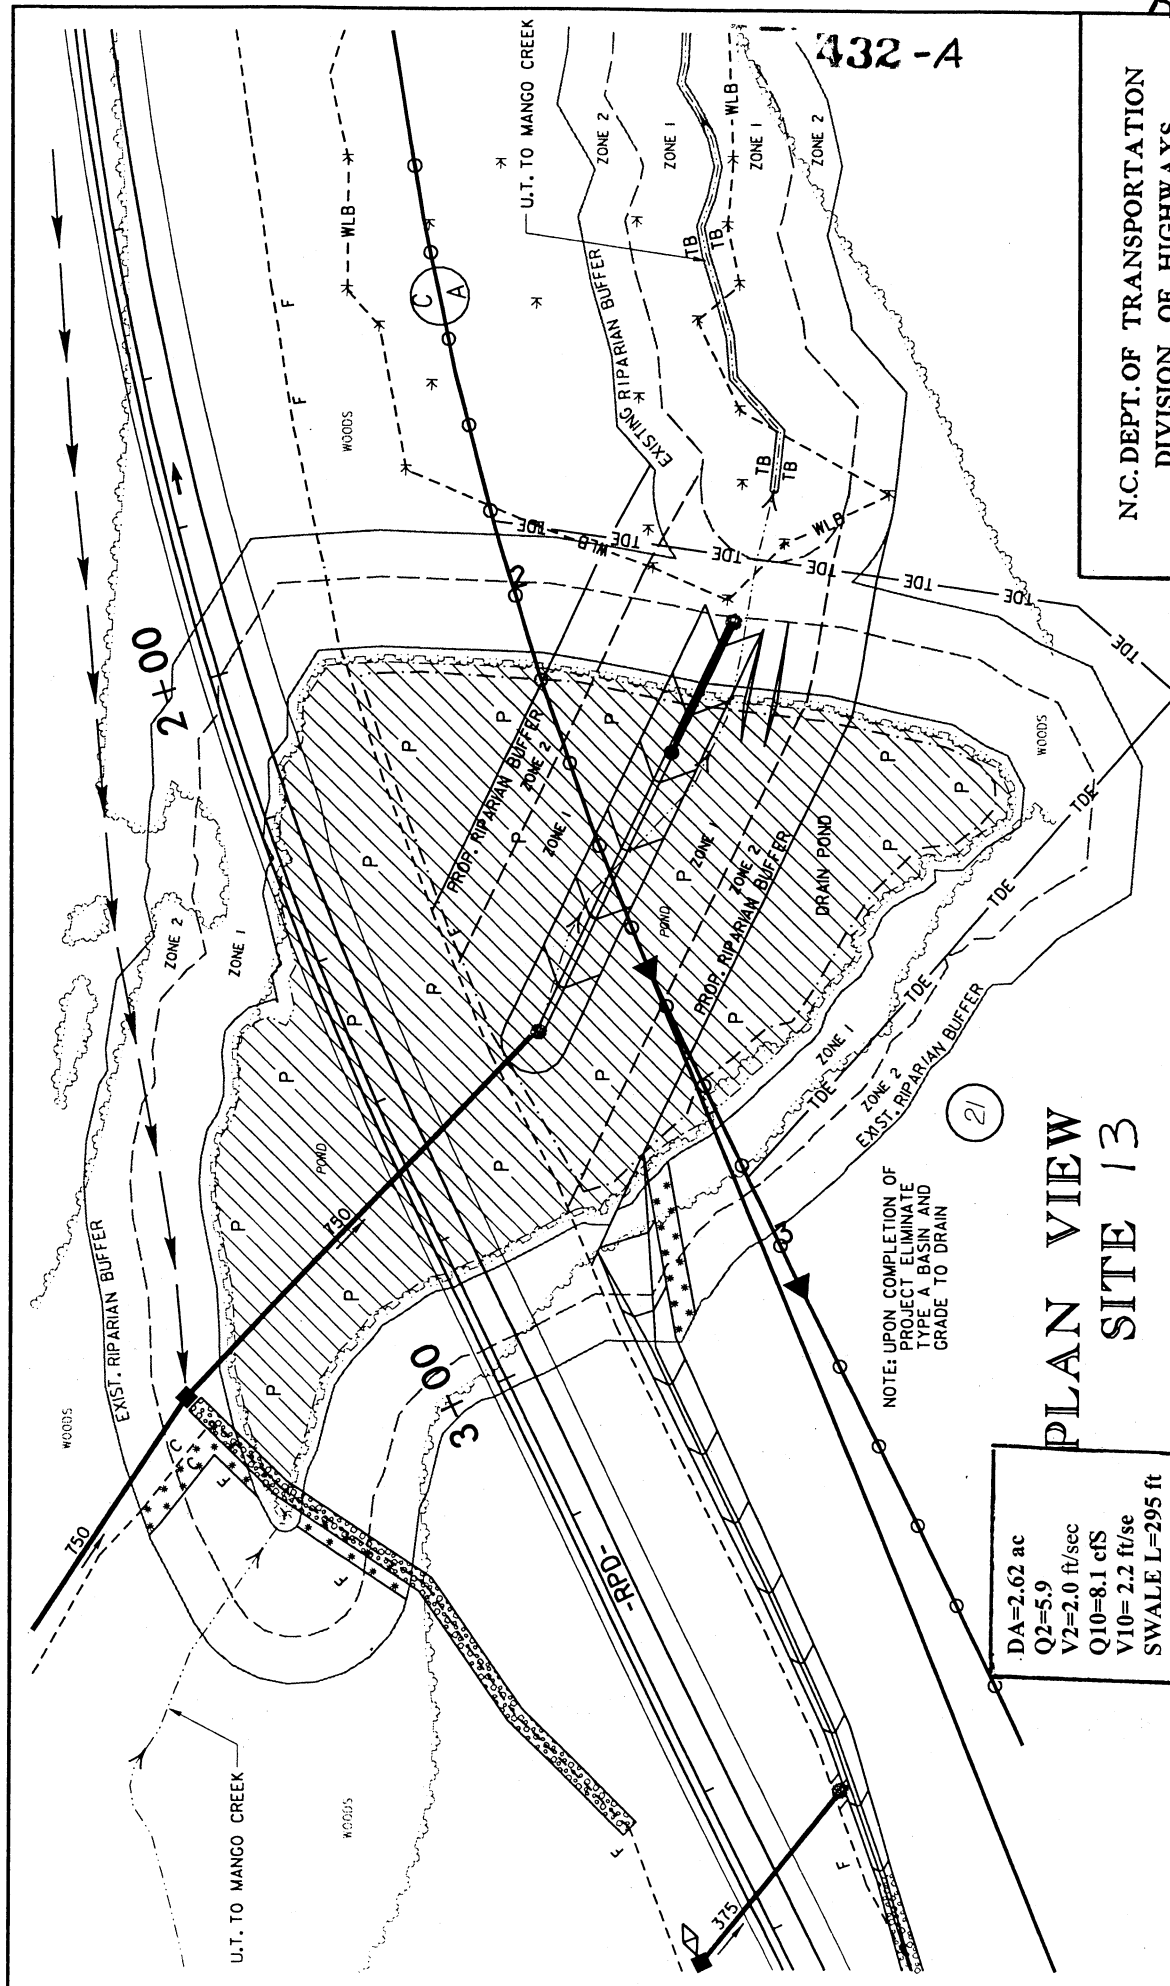

DA=2.62 ac  
Q2=5.9  
V2=2.0 ft/sec  
Q10=8.1 cfs  
V10=2.2 ft/sec  
SWALE L=295 ft  
S=3.0%  
SS=3:1

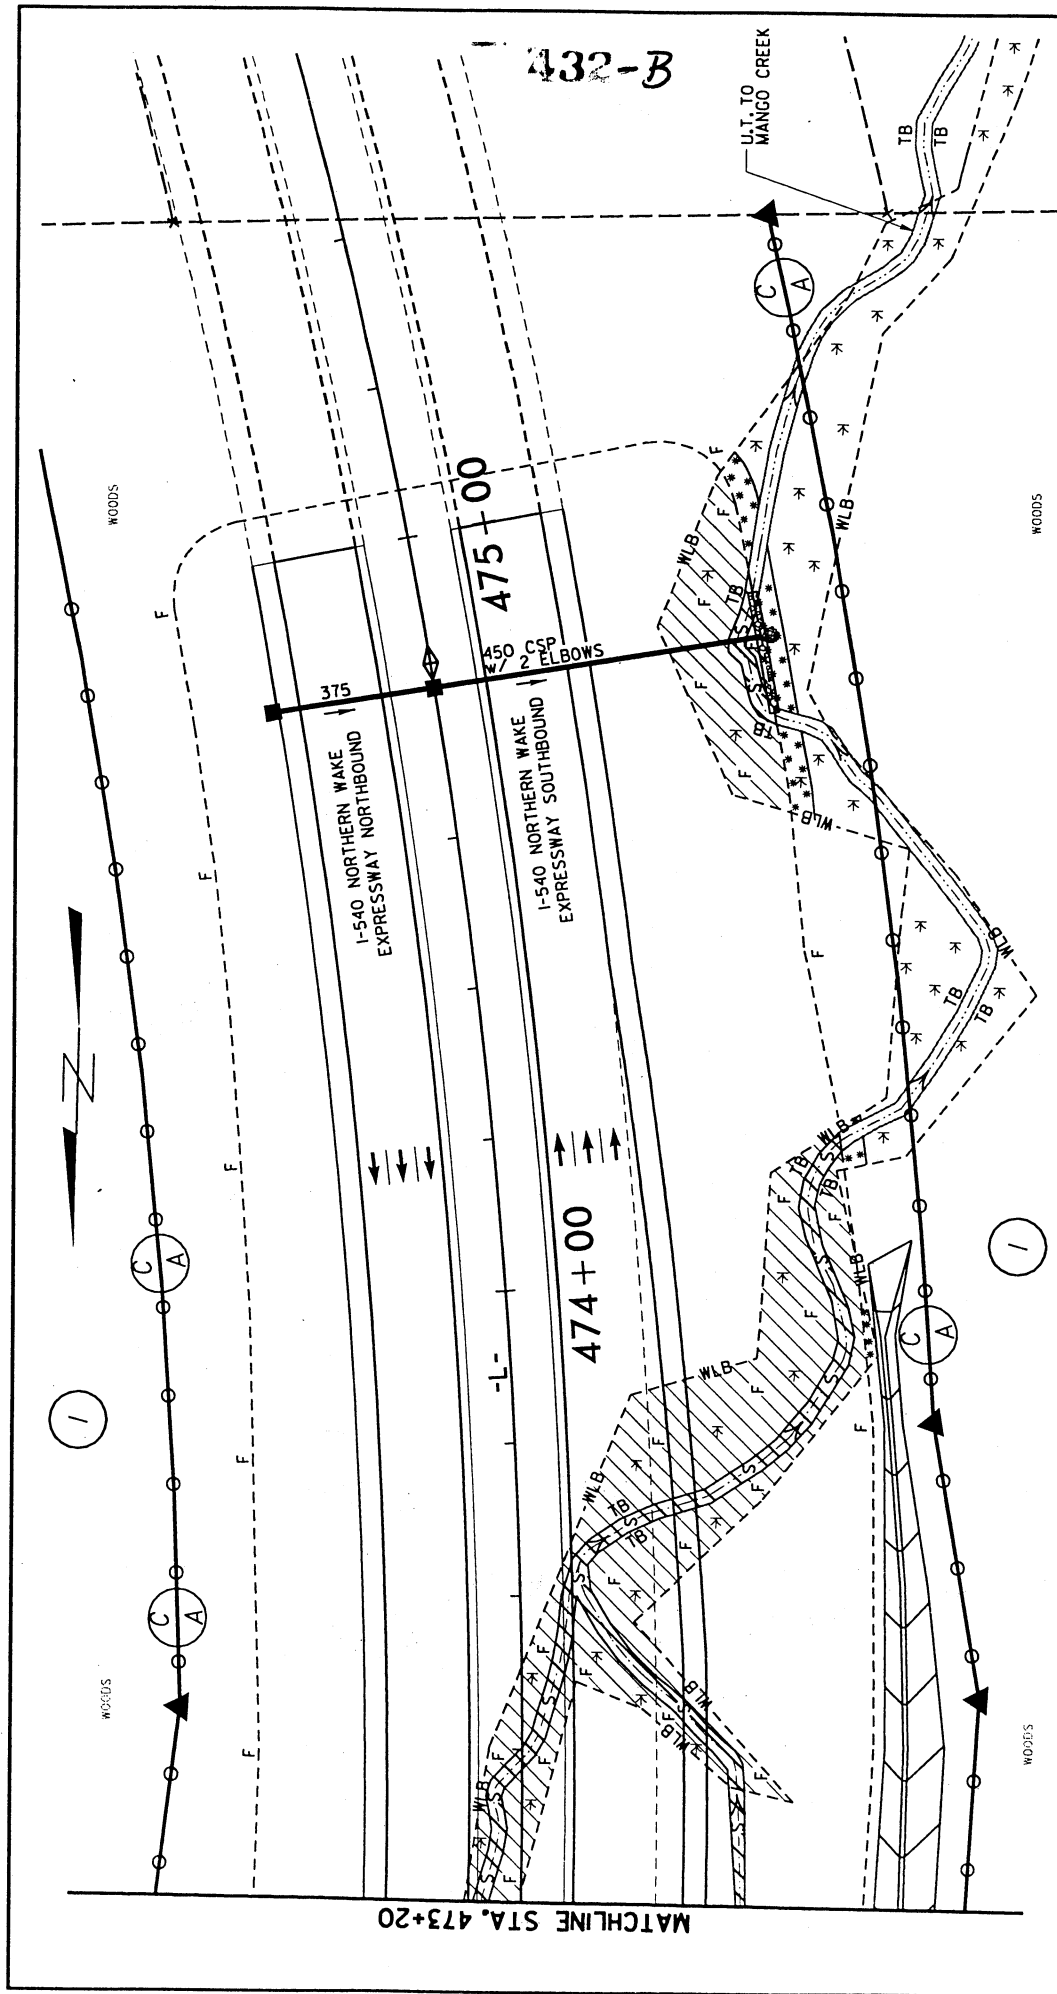

# PLAN VIEW SITE 14

- DENOTES MECHANIZED CLEARING
- DENOTES FILL IN WETLANDS
- DENOTES FILL IN SURFACE WATERS

N.C. DEPT. OF TRANSPORTATION  
DIVISION OF HIGHWAYS


WAKE COUNTY

PROJECT: 8.U401712 (R-2000G)  
I-540 NORTHERN WAKE EXPRESSWAY

SHEET \_\_\_ OF \_\_\_ 7/3/03

432-B

N.C. DEPT. OF TRANSPORTATION  
DIVISION OF HIGHWAYS  
WAKE COUNTY  
PROJECT: 8.U401712 (R-2000G)  
I-540 NORTHERN WAKE EXPRESSWAY  
SHEET \_\_\_\_ OF \_\_\_\_ 7/3/03

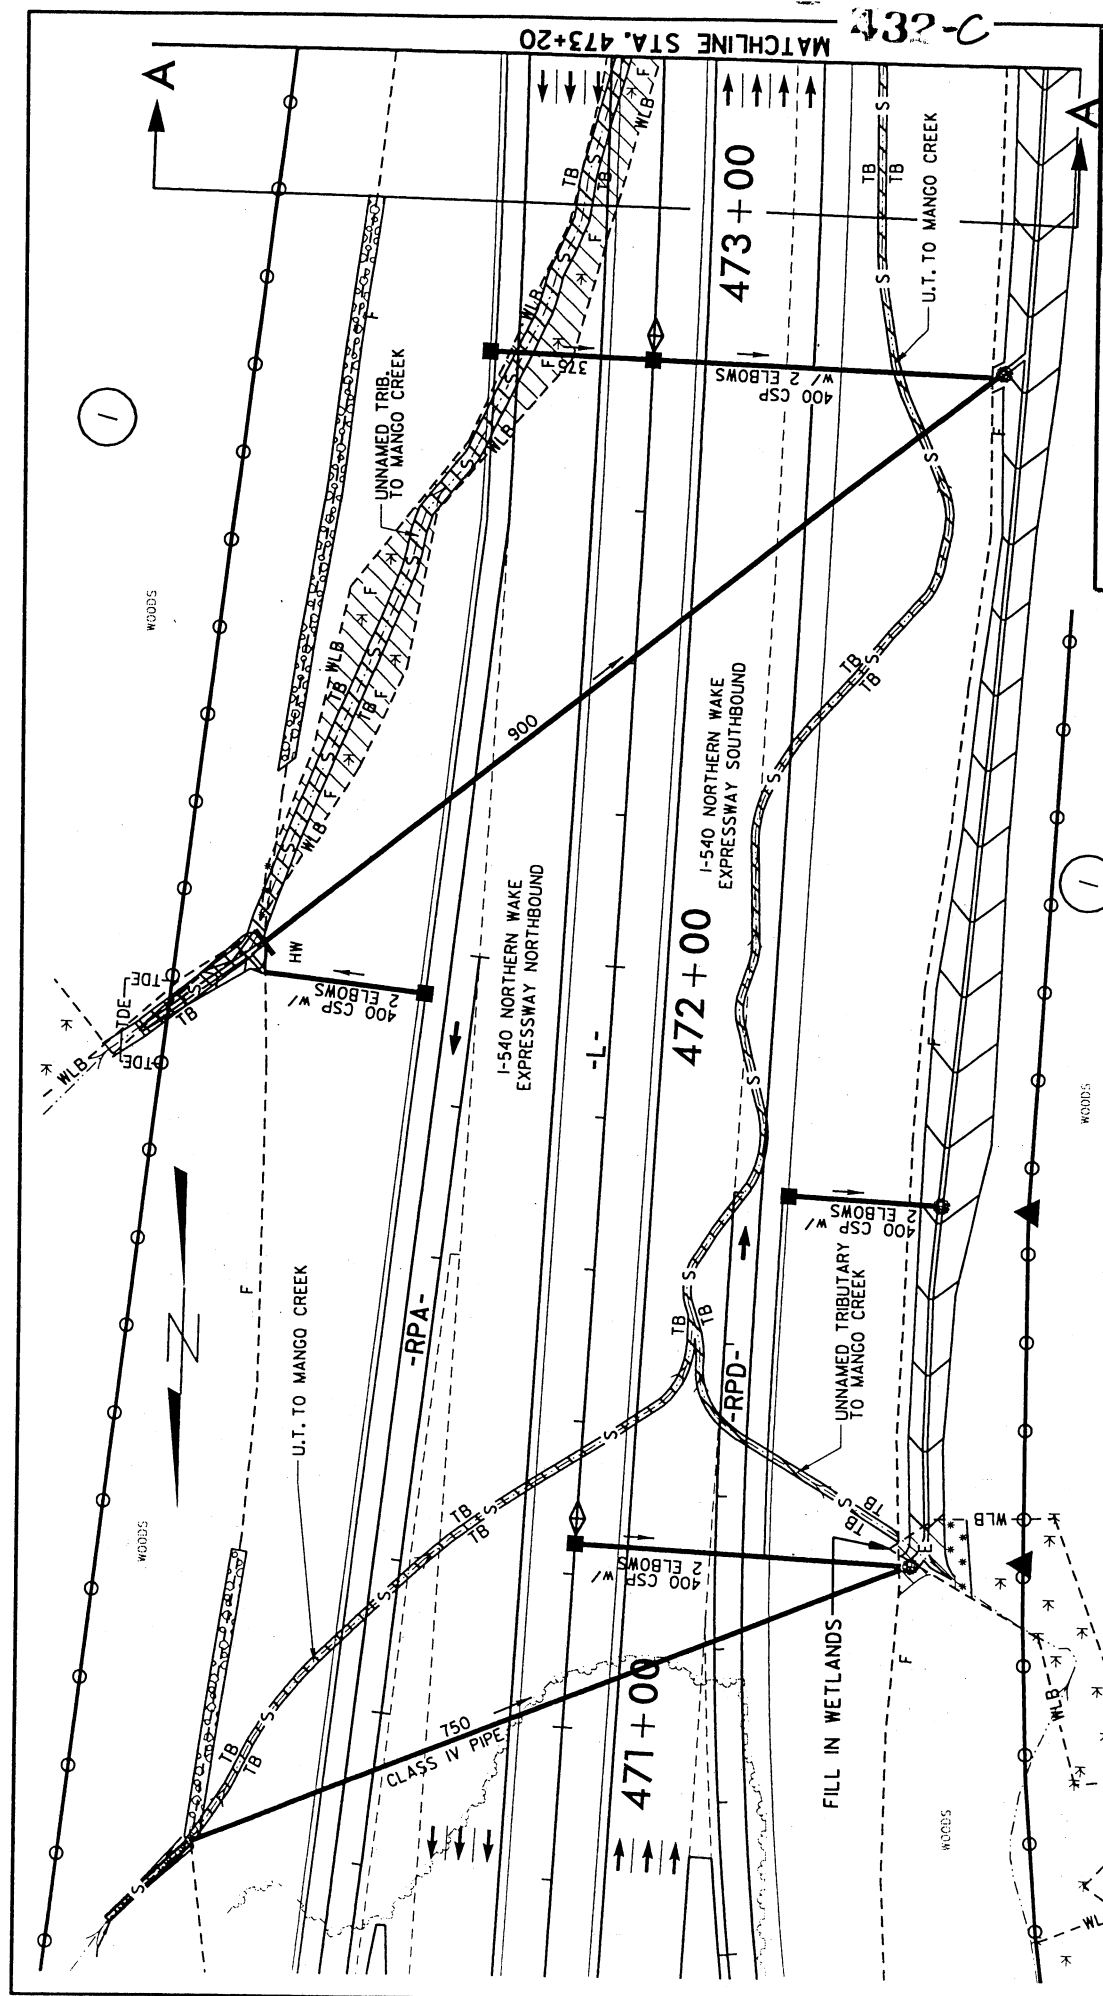


# PLAN VIEW SITE 14

- DENOTES MECHANIZED CLEARING
- DENOTES EXCAVATION IN WETLANDS
- DENOTES FILL IN WETLANDS
- DENOTES FILL IN SURFACE WATERS

DENOTES DRAINING OF POND IMPACT.  
DENOTES NO DEFINED CHANNEL.






**PAGE**  
**INTENTIONALLY**  
**BLANK**



5m 0 10m

CONST. REV.  
R/W REV.

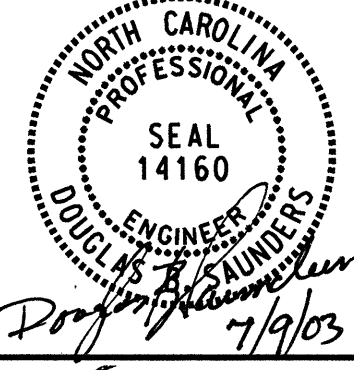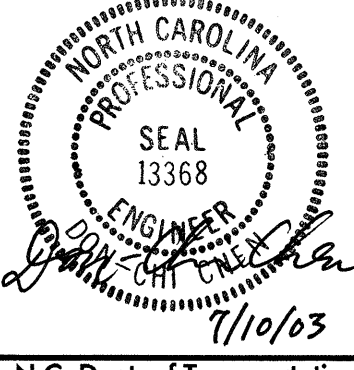PROJECT REFERENCE NO. R-2000G	SHEET NO. 2-B
ROADWAY DESIGN ENGINEER 	PAVEMENT DESIGN ENGINEER 
TRAN SITE CONSULTING ENGINEERS, INCORPORATED 1300 Paddock Drive, Suite 9-10 Raleigh, N.C. 27609	
N.C. Dept. of Transportation Pavement Management 1020 Birch Ridge Drive Raleigh, NC 27610	

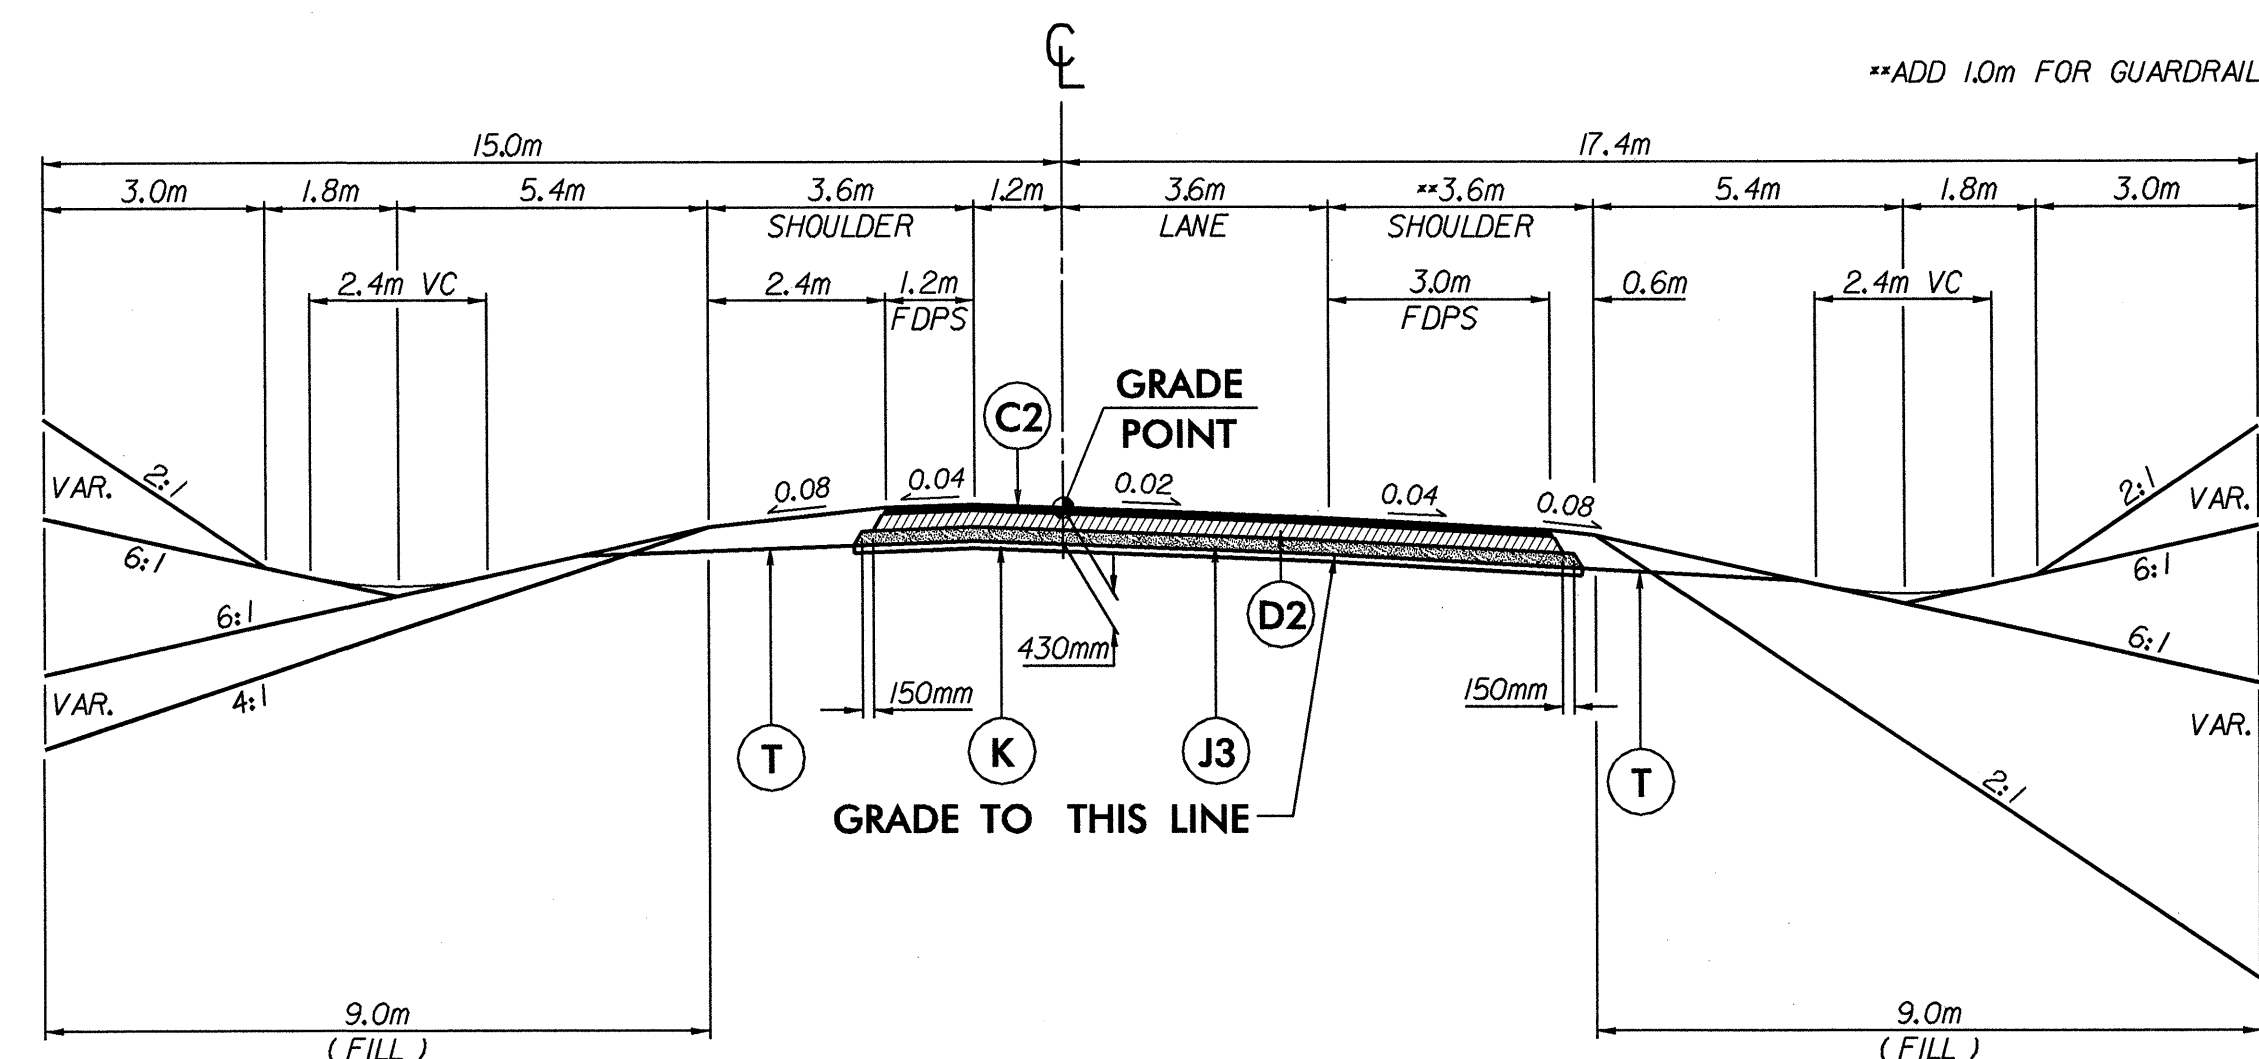


### TYPICAL SECTION NO. 3

Ramps

USE TYPICAL SECTION NO. 3 AT THE FOLLOWING LOCATIONS:

RAMP A -Y5- STA. 1+59.635 TO STA. 6+10.906  
RAMP D -Y5- STA. 1+17.764 TO STA. 5+49.688  
RAMP B -Y5- STA. 2+21.548 TO STA. 6+03.430

SEE PLANS FOR LOCATION OF TURNING LANES AND TAPERS

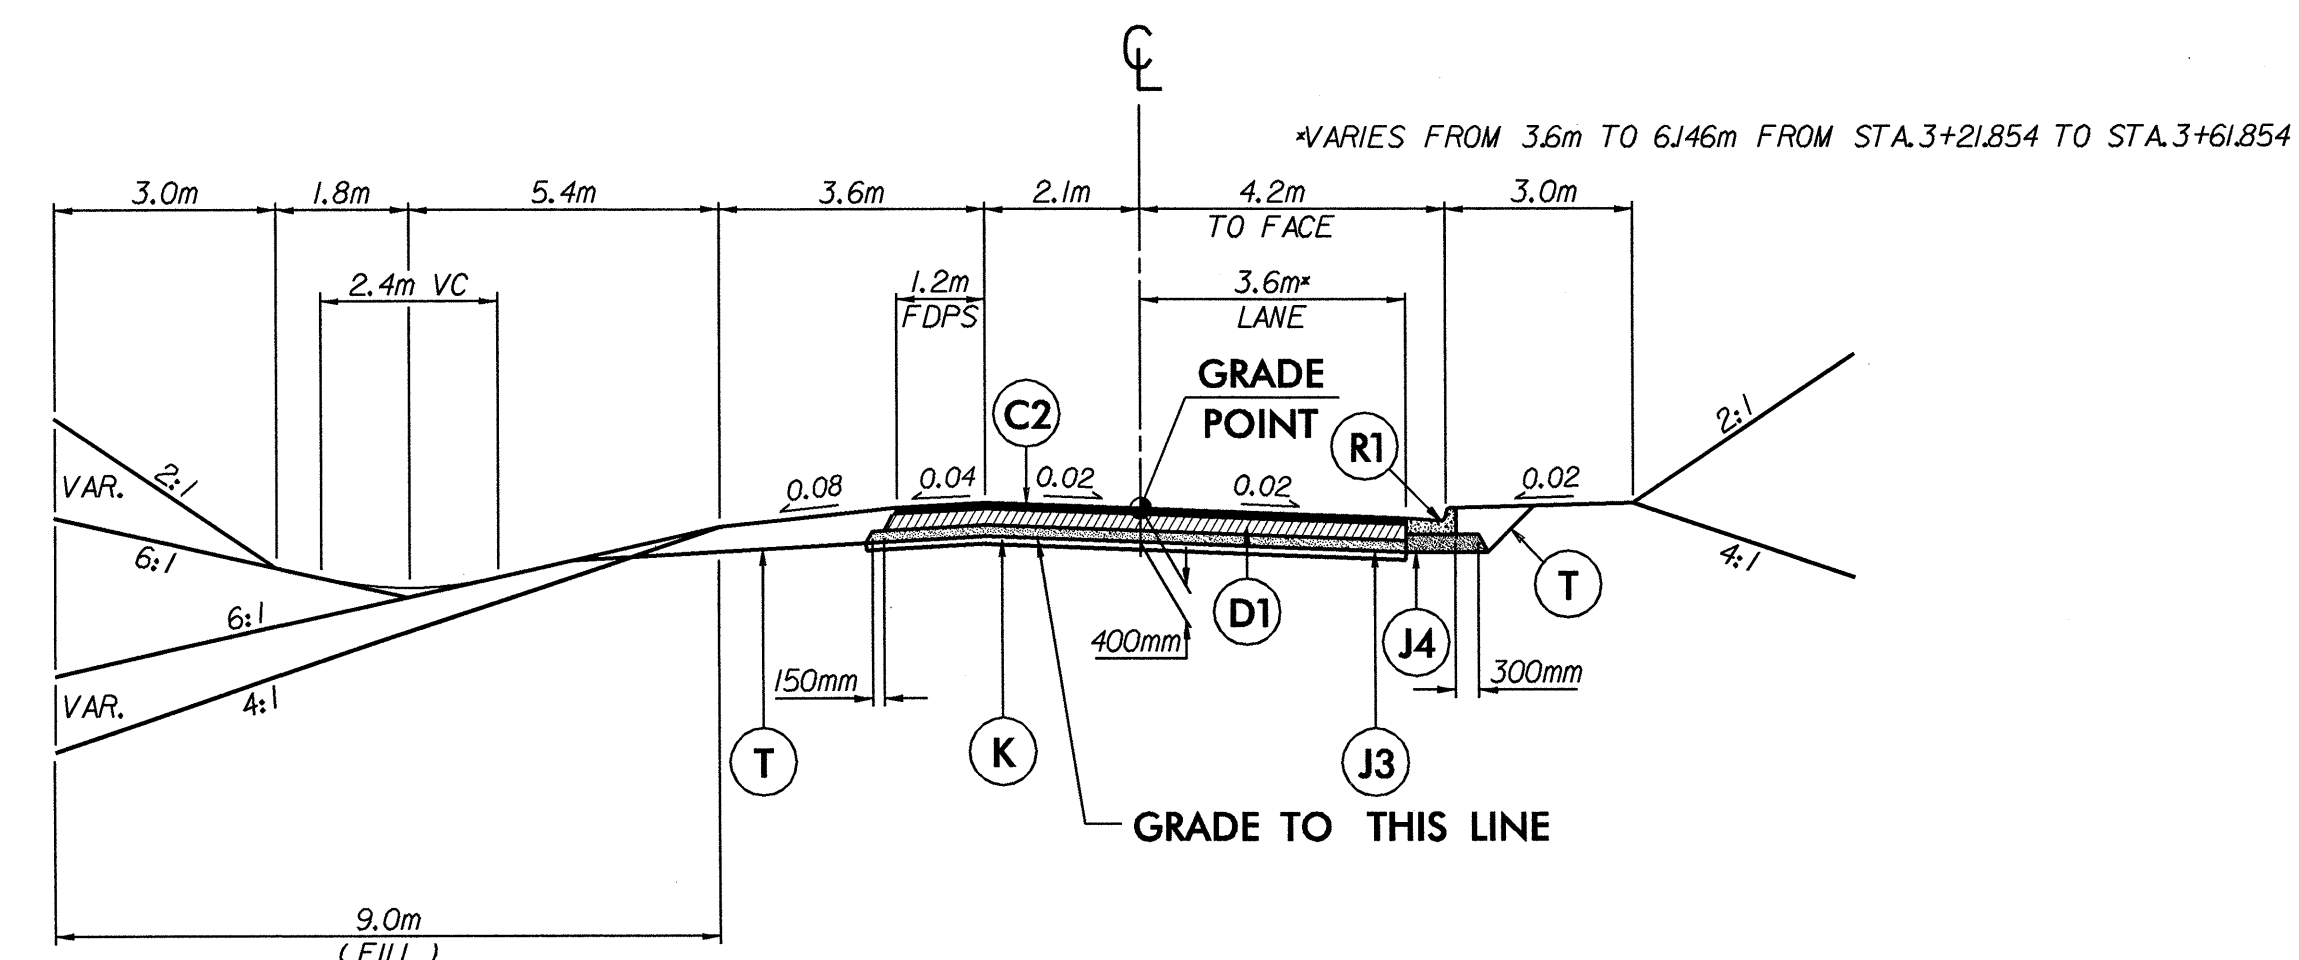

### TYPICAL SECTION NO. 4

Loop D

USE TYPICAL SECTION NO. 4 AT THE FOLLOWING LOCATIONS:


LOOP D -Y5- STA. 0+62.379 TO STA. 3+61.854

SEE PLANS FOR LOCATION OF TURNING LANES AND TAPERS

C2	70mm	S12.5C
D1	80mm	I19.0C
D2	110mm	I19.0C
J3	250mm	ABC
J4	VAR. DEPTH	ABC
K	SUBGRADE STABILIZATION	
R1	750mm	C & G
T	EARTH MATERIAL	

ALL PAVEMENT EDGE SLOPES ARE 1:1 UNLESS SHOWN OTHERWISE



197.001.001/DGN/TYPICAL/r2000g.typ rev. date: 07-09-03




5m 0 10m

CONST. REV.

R/W REV.

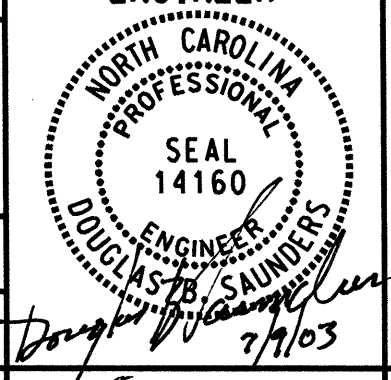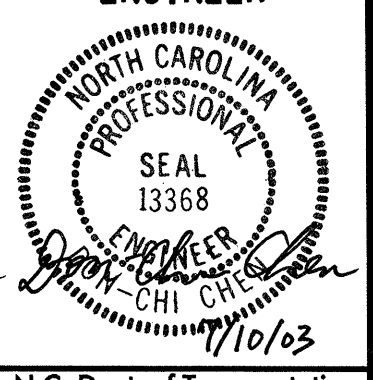PROJECT REFERENCE NO.	SHEET NO.
R-2000G	2-A
ROADWAY DESIGN ENGINEER	PAVEMENT DESIGN ENGINEER
	
TRAN SITE CONSULTING ENGINEERS, INCORPORATED 1300 Paddock Drive, Suite G-10 Raleigh, N.C. 27609	N.C. Dept. of Transportation Pavement Management 1020 Birch Ridge Drive Raleigh, NC 27610

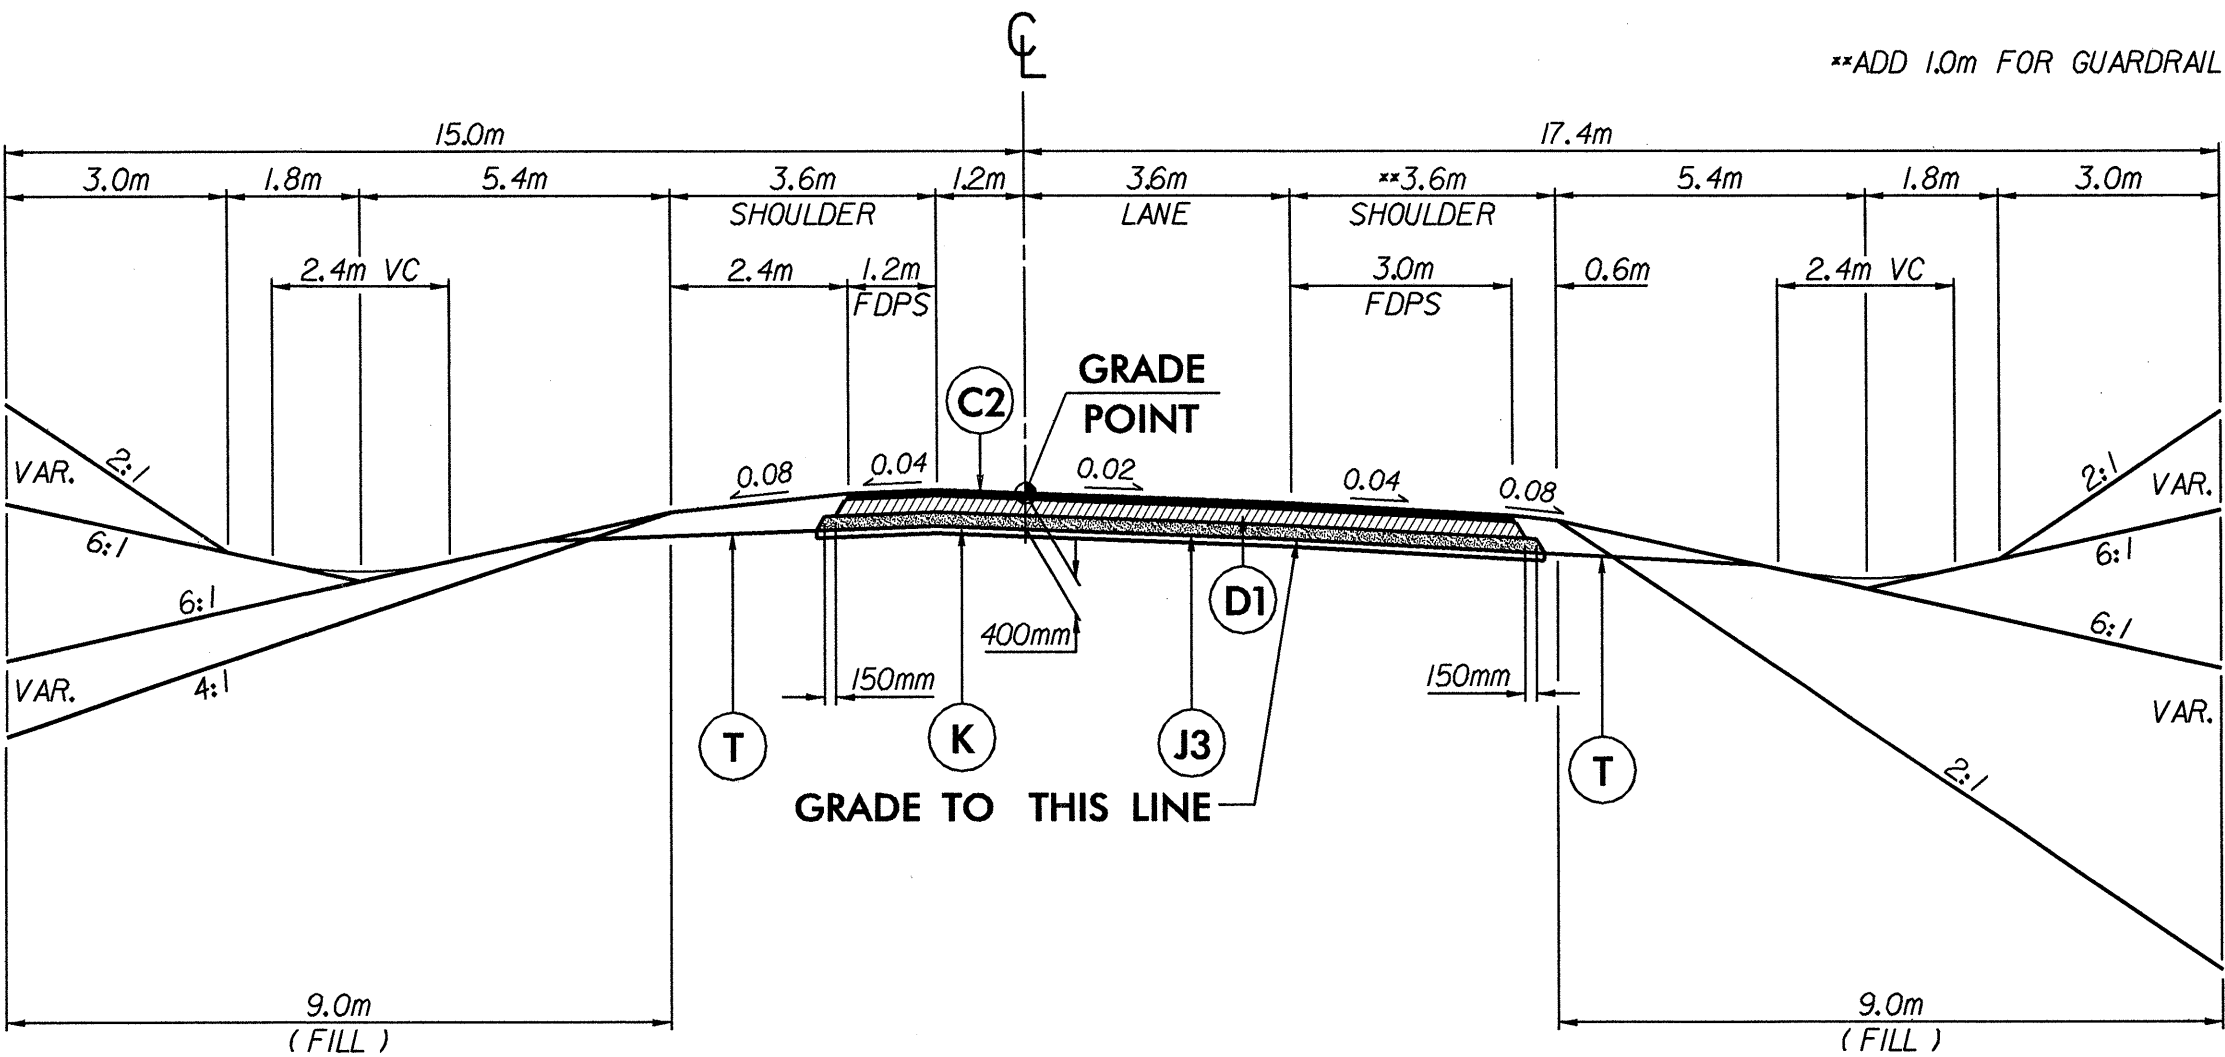


## TYPICAL SECTION NO. 2

Ramps


C2	70mm	S12.5C
D1	80mm	I19.0C
J3	250mm	ABC
K	SUBGRADE STABILIZATION	
T	EARTH MATERIAL	

ALL PAVEMENT EDGE SLOPES ARE 1:1 UNLESS SHOWN OTHERWISE


USE TYPICAL SECTION NO. 2 AT THE FOLLOWING LOCATIONS:  
RAMP C -Y5- STA. 1+45.560 TO STA. 6+69.315  
SEE PLANS FOR LOCATION OF TURNING LANES AND TAPERS

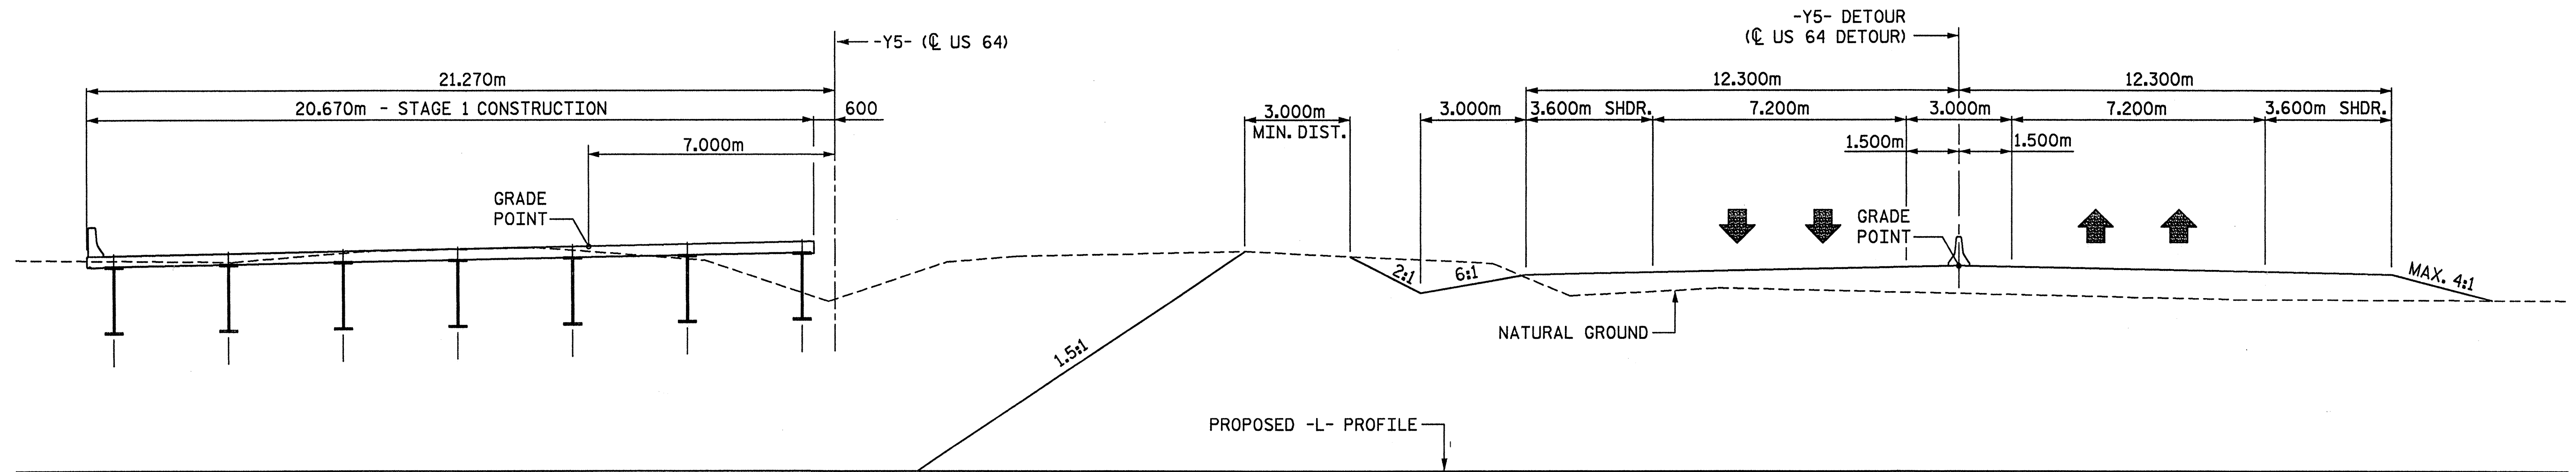

STAGE 1 CONSTRUCTION


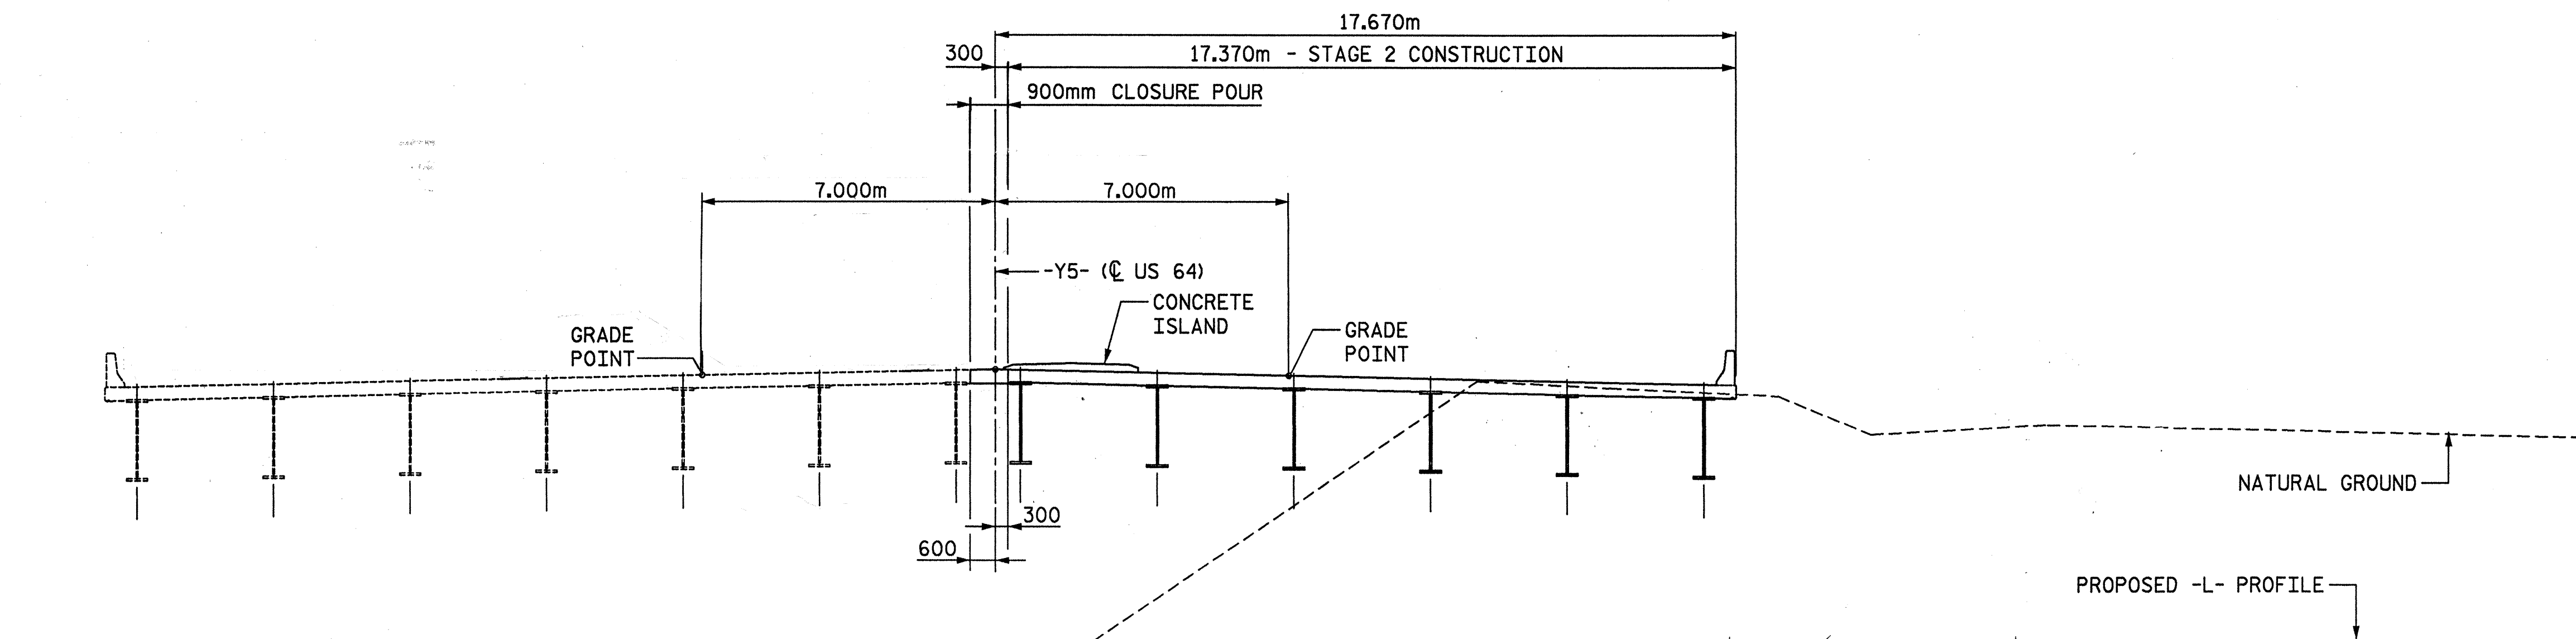


STAGE 2 CONSTRUCTION AND CLOSURE POUR

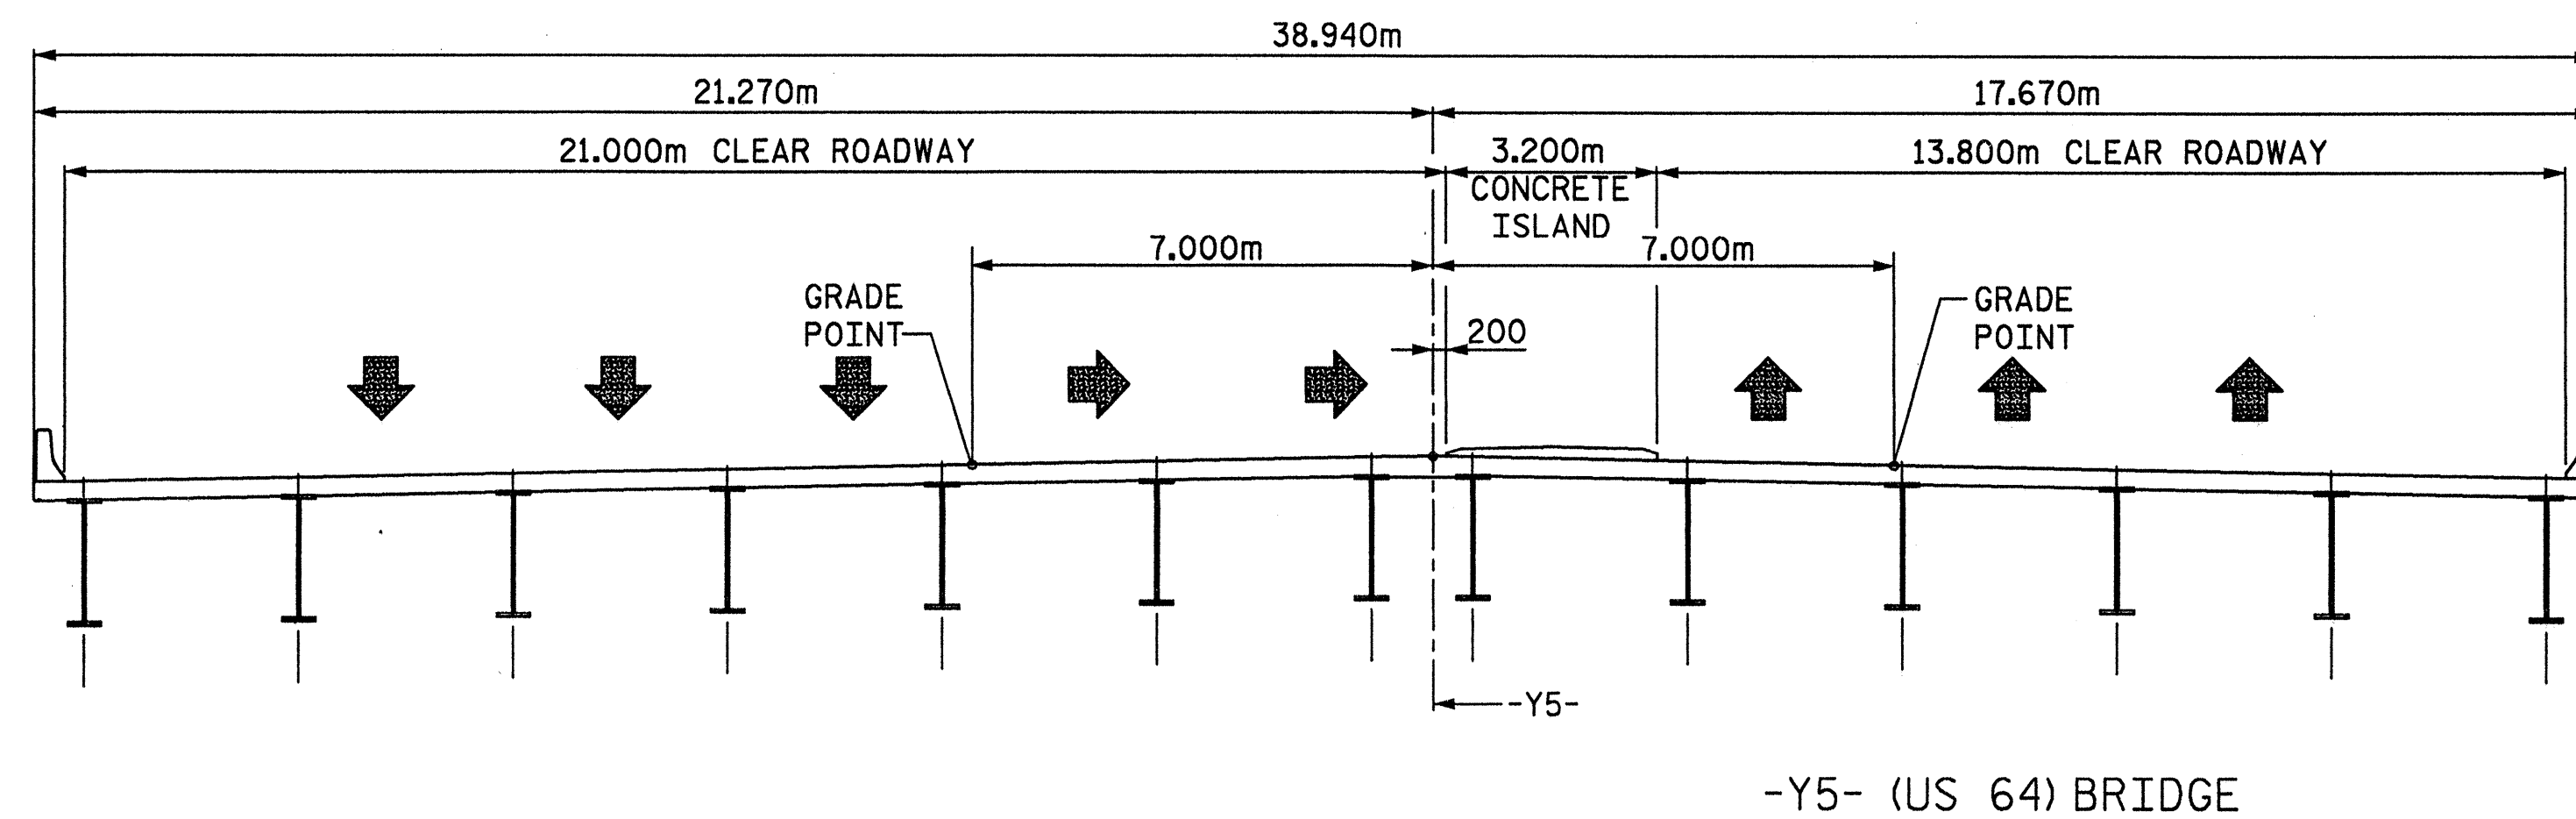

-Y5- (US 64) BRIDGE

PROJECT NO. R-2000G  
WAKE COUNTY  
 STATION: 465+66.727 -L- POT

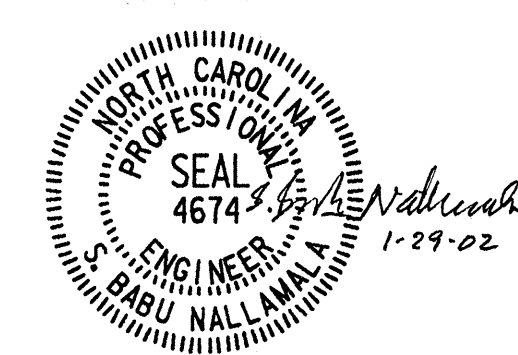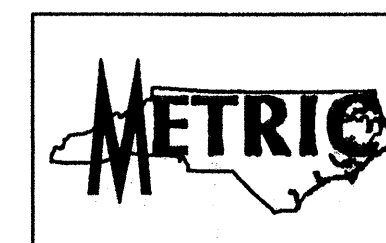


**Nallamala & Wilson, P.A.**  
 1399 Ashleybrook Lane, Suite 130  
 Winston-Salem, N.C. 27103-2918  
 Ph: (336) 765-4651 Fax: (336) 765-6194  
 DWG. NO. 2101(3) - 4

STATE OF NORTH CAROLINA  
 DEPARTMENT OF TRANSPORTATION  
 RALEIGH  
 CONSTRUCTION SEQUENCE  
 FOR BRIDGE ON US 64 OVER  
 I-540 RALEIGH OUTER LOOP

REVISIONS						SHEET NO.
NO.	BY:	DATE:	NO.	BY:	DATE:	
1			3			8-108
2			4			TOTAL SHEETS 145

DRAWN BY: A.S. CALLAWAY DATE: 07/26/01  
 CHECKED BY: *[Signature]* DATE: 1-29-02



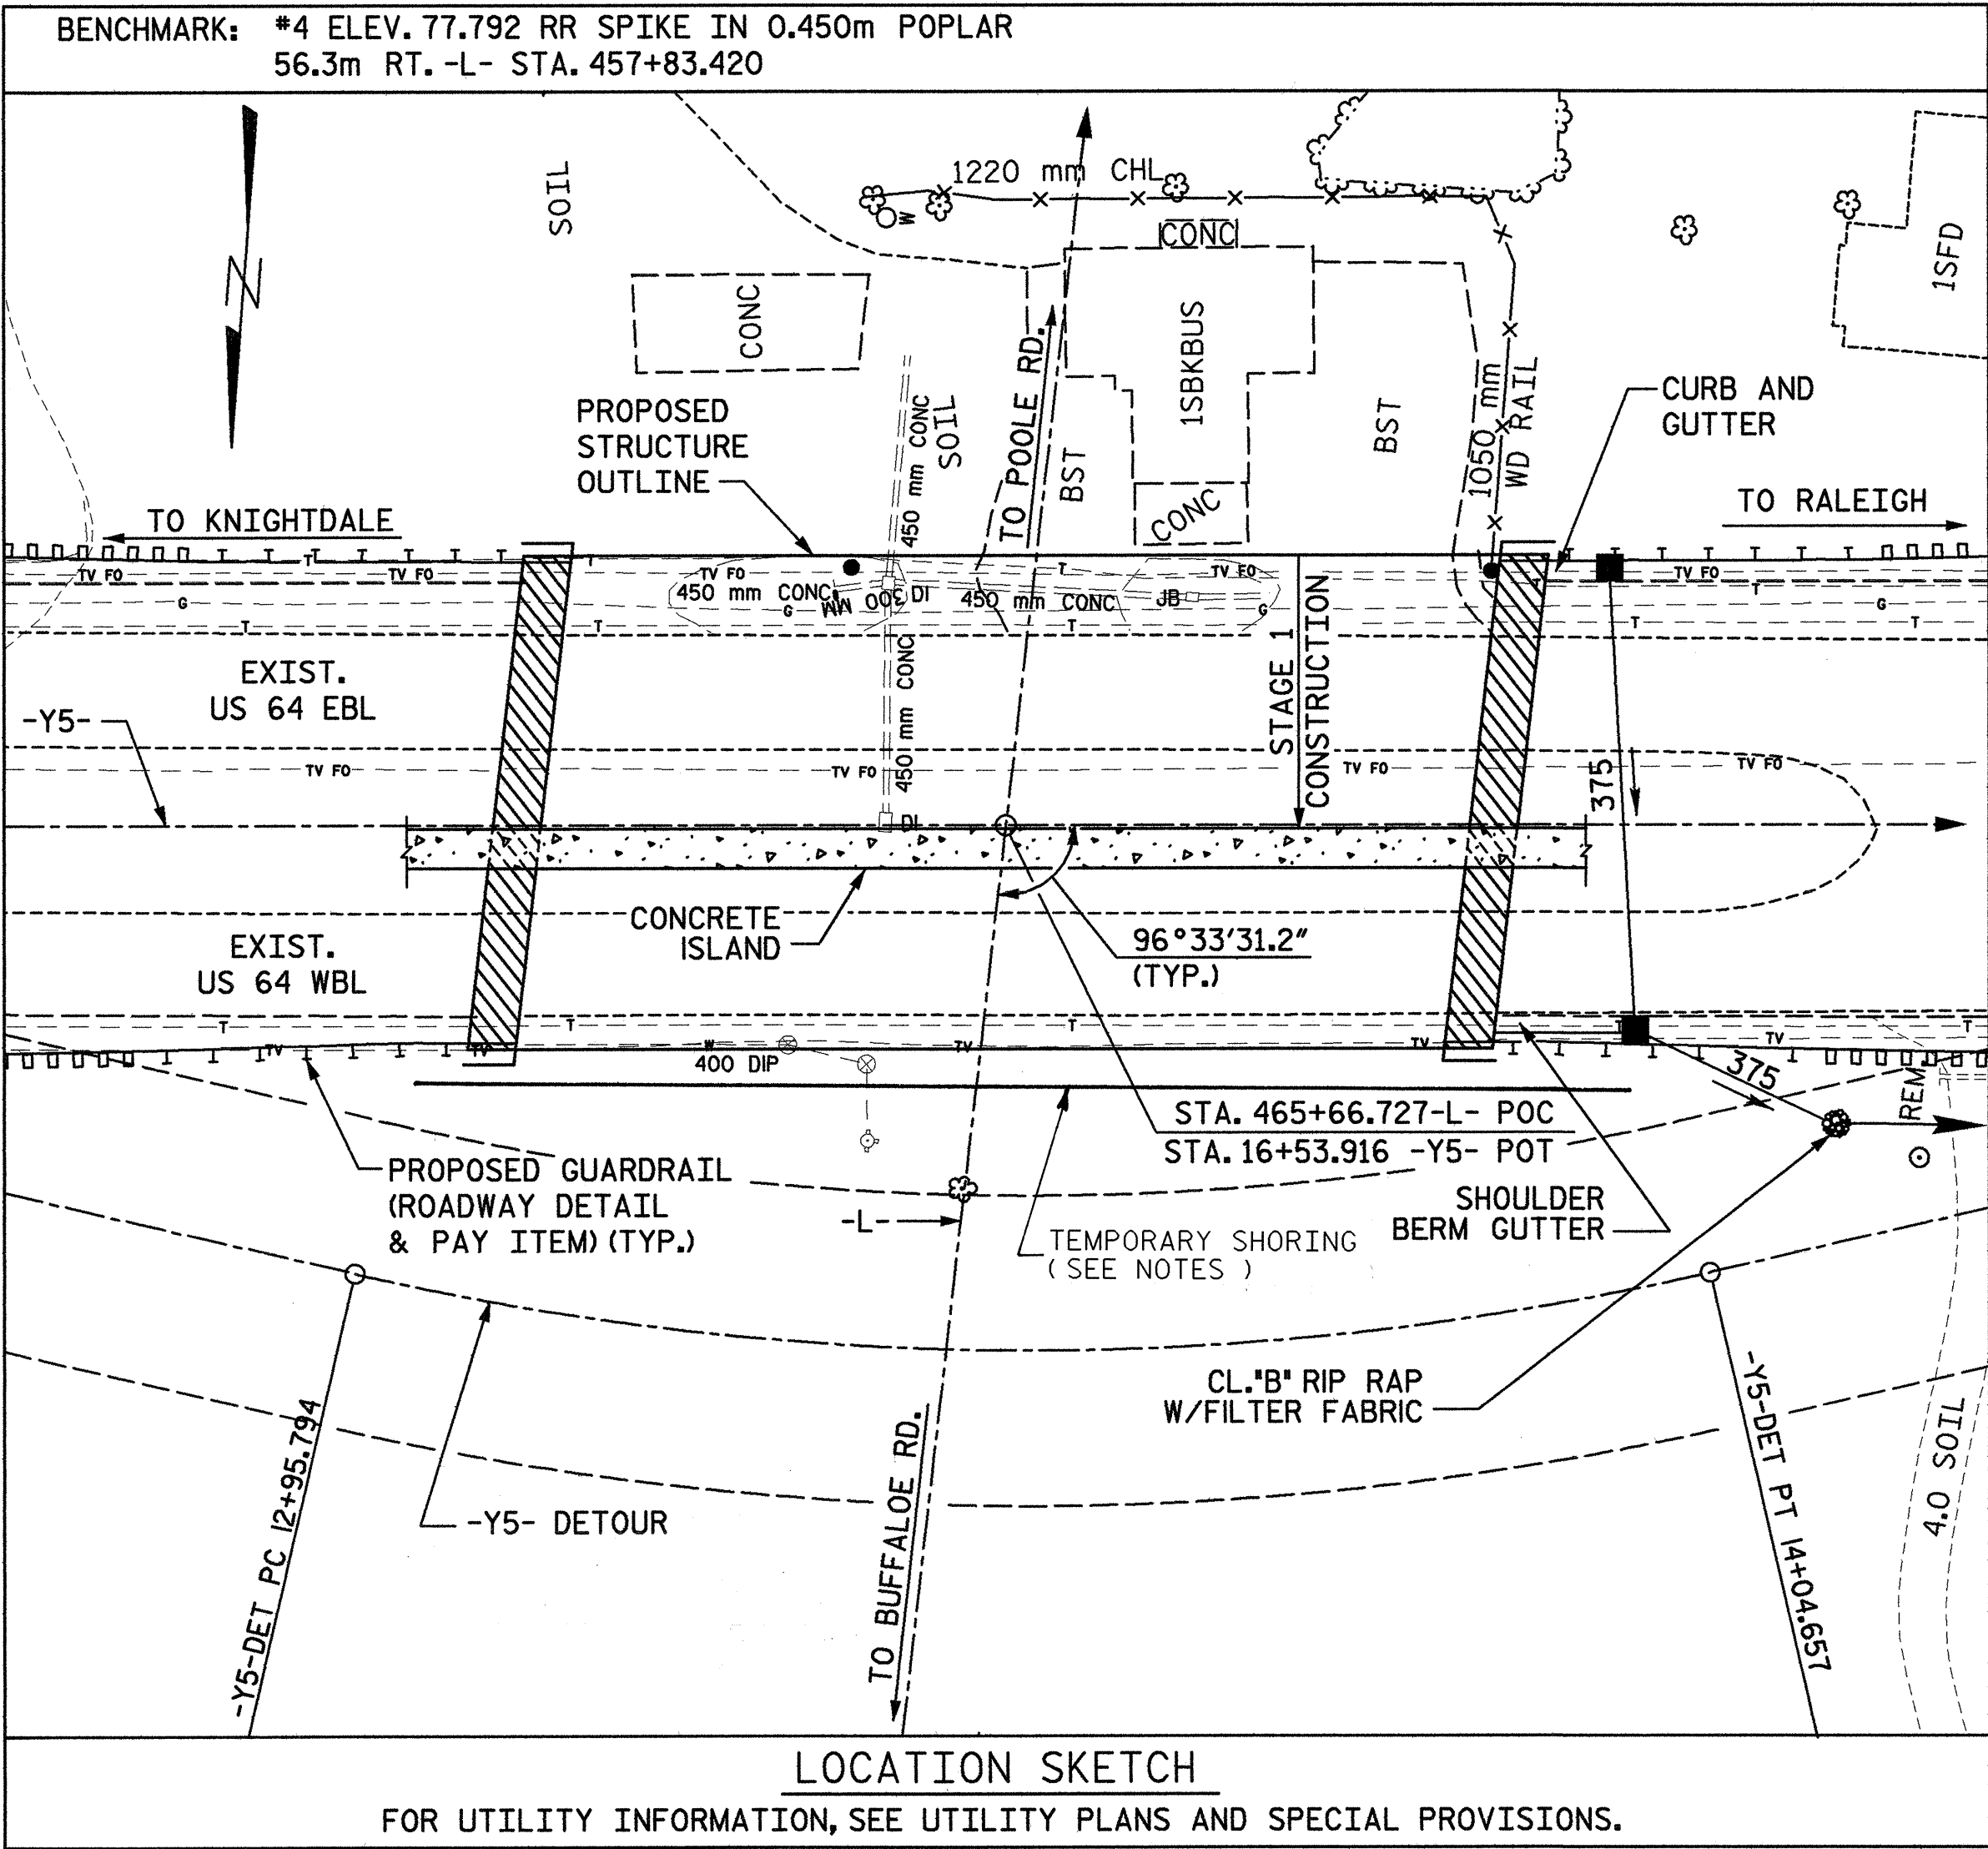

NOTES

ASSUMED LIVE LOAD = MS18 OR ALTERNATE LOADING.

THIS BRIDGE HAS BEEN DESIGNED IN ACCORDANCE WITH THE REQUIREMENTS OF THE STANDARD SPECIFICATIONS FOR SEISMIC DESIGN OF HIGHWAY BRIDGES FOR SEISMIC PERFORMANCE CATEGORY A.

ALL DIMENSIONS ARE IN MILLIMETERS UNLESS OTHERWISE NOTED.

ALL ELEVATIONS ARE IN METERS.

THIS BRIDGE HAS BEEN DESIGNED BY THE STRENGTH DESIGN METHOD AS SPECIFIED IN AASHTO STANDARD SPECIFICATIONS.

FOR OTHER DESIGN DATA AND GENERAL NOTES, SEE SHEET SNSM.

THE CONTRACTOR SHALL PROVIDE INDEPENDENT ASSURANCE SAMPLES OF REINFORCING STEEL AS FOLLOWS: FOR PROJECTS REQUIRING UP TO 360,000 kg OF REINFORCING STEEL, ONE 760mm SAMPLE OF EACH SIZE BAR USED, AND FOR PROJECTS REQUIRING OVER 360,000 kg OF REINFORCING STEEL, TWO 760mm SAMPLES OF EACH SIZE BAR USED. THE BARS FROM WHICH THE SAMPLES ARE TAKEN MUST THEN BE SPLICED WITH REPLACEMENT BARS OF THE SIZE AND LENGTH OF THE SAMPLE PLUS A MINIMUM LAP SPLICE OF THIRTY BAR DIAMETERS.

ALL STRUCTURAL STEEL SHALL BE AASHTO M270 GRADE 345W AND PAINTED IN ACCORDANCE WITH SYSTEM 4 OF ARTICLE 442-7 OF THE STANDARD SPECIFICATIONS UNLESS OTHERWISE NOTED ON THE PLANS.

THE CLASS AA CONCRETE IN THE BRIDGE DECK SHALL CONTAIN FLY ASH OR GROUND GRANULATED BLAST FURNACE SLAG AT THE SUBSTITUTION RATE SPECIFIED IN ARTICLE 1024-1 AND IN ACCORDANCE WITH ARTICLES 1024-5 AND 1024-6 OF THE STANDARD SPECIFICATIONS. NO PAYMENT WILL BE MADE FOR THIS SUBSTITUTION AS IT IS CONSIDERED INCIDENTAL TO THE COST OF THE REINFORCED CONCRETE DECK SLAB.

PILES FOR END BENTS NO.1 & 2 SHALL BE DRIVEN TO A MINIMUM BEARING CAPACITY OF 530 kN EACH.

THE REQUIRED BEARING CAPACITY OF THE SPREAD FOOTINGS AT BENT NO.1 IS 380 kPa. THE REQUIRED BEARING CAPACITY SHALL BE VERIFIED.

WORK SHALL NOT BE STARTED ON THIS BRIDGE, AT EACH STAGE OF CONSTRUCTION, UNTIL ROADWAY SECTION IN THAT STAGE HAS BEEN EXCAVATED.

WAITING PERIOD FOR THE APPROACH SLAB CONSTRUCTION SHALL BE WAIVED.

FOR EROSION CONTROL MEASURES, SEE EROSION CONTROL PLANS.

FOR SUBMITTAL OF WORKING DRAWINGS, SEE SPECIAL PROVISIONS.

FOR METRIC STRUCTURAL STEEL, SEE SPECIAL PROVISIONS.

FOR FALSEWORK AND FORMWORK, SEE SPECIAL PROVISIONS.



NEEDLE BEAMS WILL NOT BE ALLOWED UNLESS OTHERWISE CALLED FOR ON THE PLANS OR APPROVED BY THE ENGINEER.

FOR LIMITS OF TEMPORARY SHORING FOR MAINTENANCE OF TRAFFIC, SEE TRAFFIC CONTROL PLANS. FOR PAY ITEM FOR TEMPORARY SHORING FOR MAINTENANCE OF TRAFFIC, SEE ROADWAY PLANS.

STEEL SHEET PILING REQUIRED FOR SHORING SHALL BE HOT ROLLED.

TOTAL BILL OF MATERIAL															
	FOUNDATION EXCAVATION	REINFORCED CONCRETE DECK SLAB	GROOVING BRIDGE FLOORS	CLASS A CONCRETE	BRIDGE APPROACH SLABS	REINFORCING STEEL	SPIRAL COLUMN REINFORCING STEEL	STRUCTURAL STEEL	HP310x79 STEEL PILES		CONCRETE BARRIER RAIL	100mm SLOPE PROTECTION	TFE EXP. BEARING ASSEMBLIES	ELASTOMERIC BEARINGS	EVAZOTE JOINT SEALS
	LUMP SUM	SQ. METERS	SQ. METERS	CU. METERS	LUMP SUM	Kg	Kg	APPROX. Kg	NO.	LIN. METERS	LIN. METERS	SQ. METERS	LUMP SUM	LUMP SUM	LUMP SUM
SUPERSTRUCTURE	————	2,905.5	2,444.9	————	————	————	————	389,900	——	————	149.228	————	LUMP SUM	LUMP SUM	LUMP SUM
END BENT 1	————	————	————	89.4	LUMP SUM	8,233	————	————	34	204	————	490	————	————	————
BENT 1	LUMP SUM	————	————	213.5	————	19,047	1,692	————	——	————	————	————	————	————	————
END BENT 2	————	————	————	89.1	LUMP SUM	8,212	————	————	34	204	————	440	————	————	————
TOTAL	LUMP SUM	2,905.5	2,444.9	392.0	LUMP SUM	35,492	1,692	389,900	68	408	149.228	930	LUMP SUM	LUMP SUM	LUMP SUM

DRAWN BY : A. STEPHEN CALLAWAY DATE : 07/20/01  
CHECKED BY : S. B. NALLAMALA DATE : 2-22-02

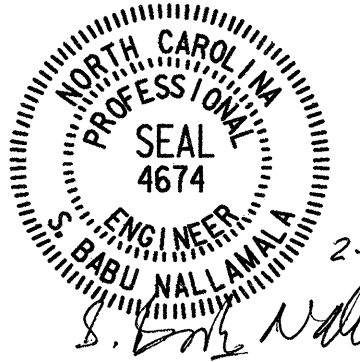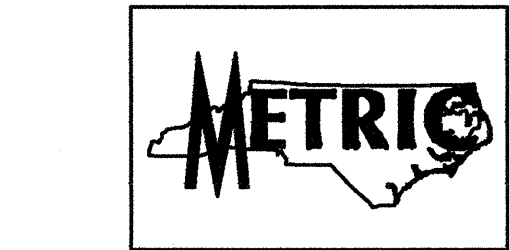

Nallamala & Wilson, P.A.  
1399 Ashleybrook Lane, Suite 130  
Winston-Salem, N.C. 27103-2918  
Ph: (336) 765-4651 Fax: (336) 765-6194  
DWG. NO. 2101(3)-3

PROJECT NO. R-2000G  
WAKE COUNTY  
STATION: 465+66.727 -L- POT


SHEET 3 OF 3

STATE OF NORTH CAROLINA  
DEPARTMENT OF TRANSPORTATION  
RALEIGH  
GENERAL DRAWING  
FOR BRIDGE ON US-64 OVER  
I-540 RALEIGH OUTER LOOP

REVISIONS						SHEET NO.
NO.	BY	DATE	NO.	BY	DATE	
1			3			5-107
2			4			


PVI STA. = 15+70.000  
ELEV. = 98.663  
VC = 105.000m

105.000  
100.000  
95.000  
90.000  
85.000

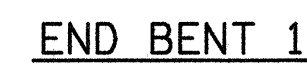


BENT 1

SECTION ALONG -Y5-

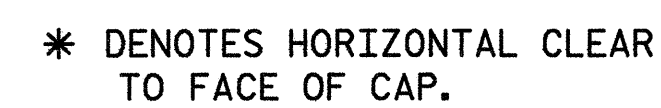

## PLAN



WAKE COUNTY

SHEET 1 OF 3 BRIDGE NO. 1016


Nallamala & Wilson, P.A.

1399 Ashleybrook Lane, Suite 130  
Winston-Salem, N.C. 27103-2918  
Ph: (336) 765-4651 Fax: (336) 765-619

DWG. NO. 2101(3)- I

REVISIONS						SHEET NO. S-105
NO.	BY:	DATE:	NO.	BY:	DATE:	
1			3			TOTAL SHEETS 105
2			4			



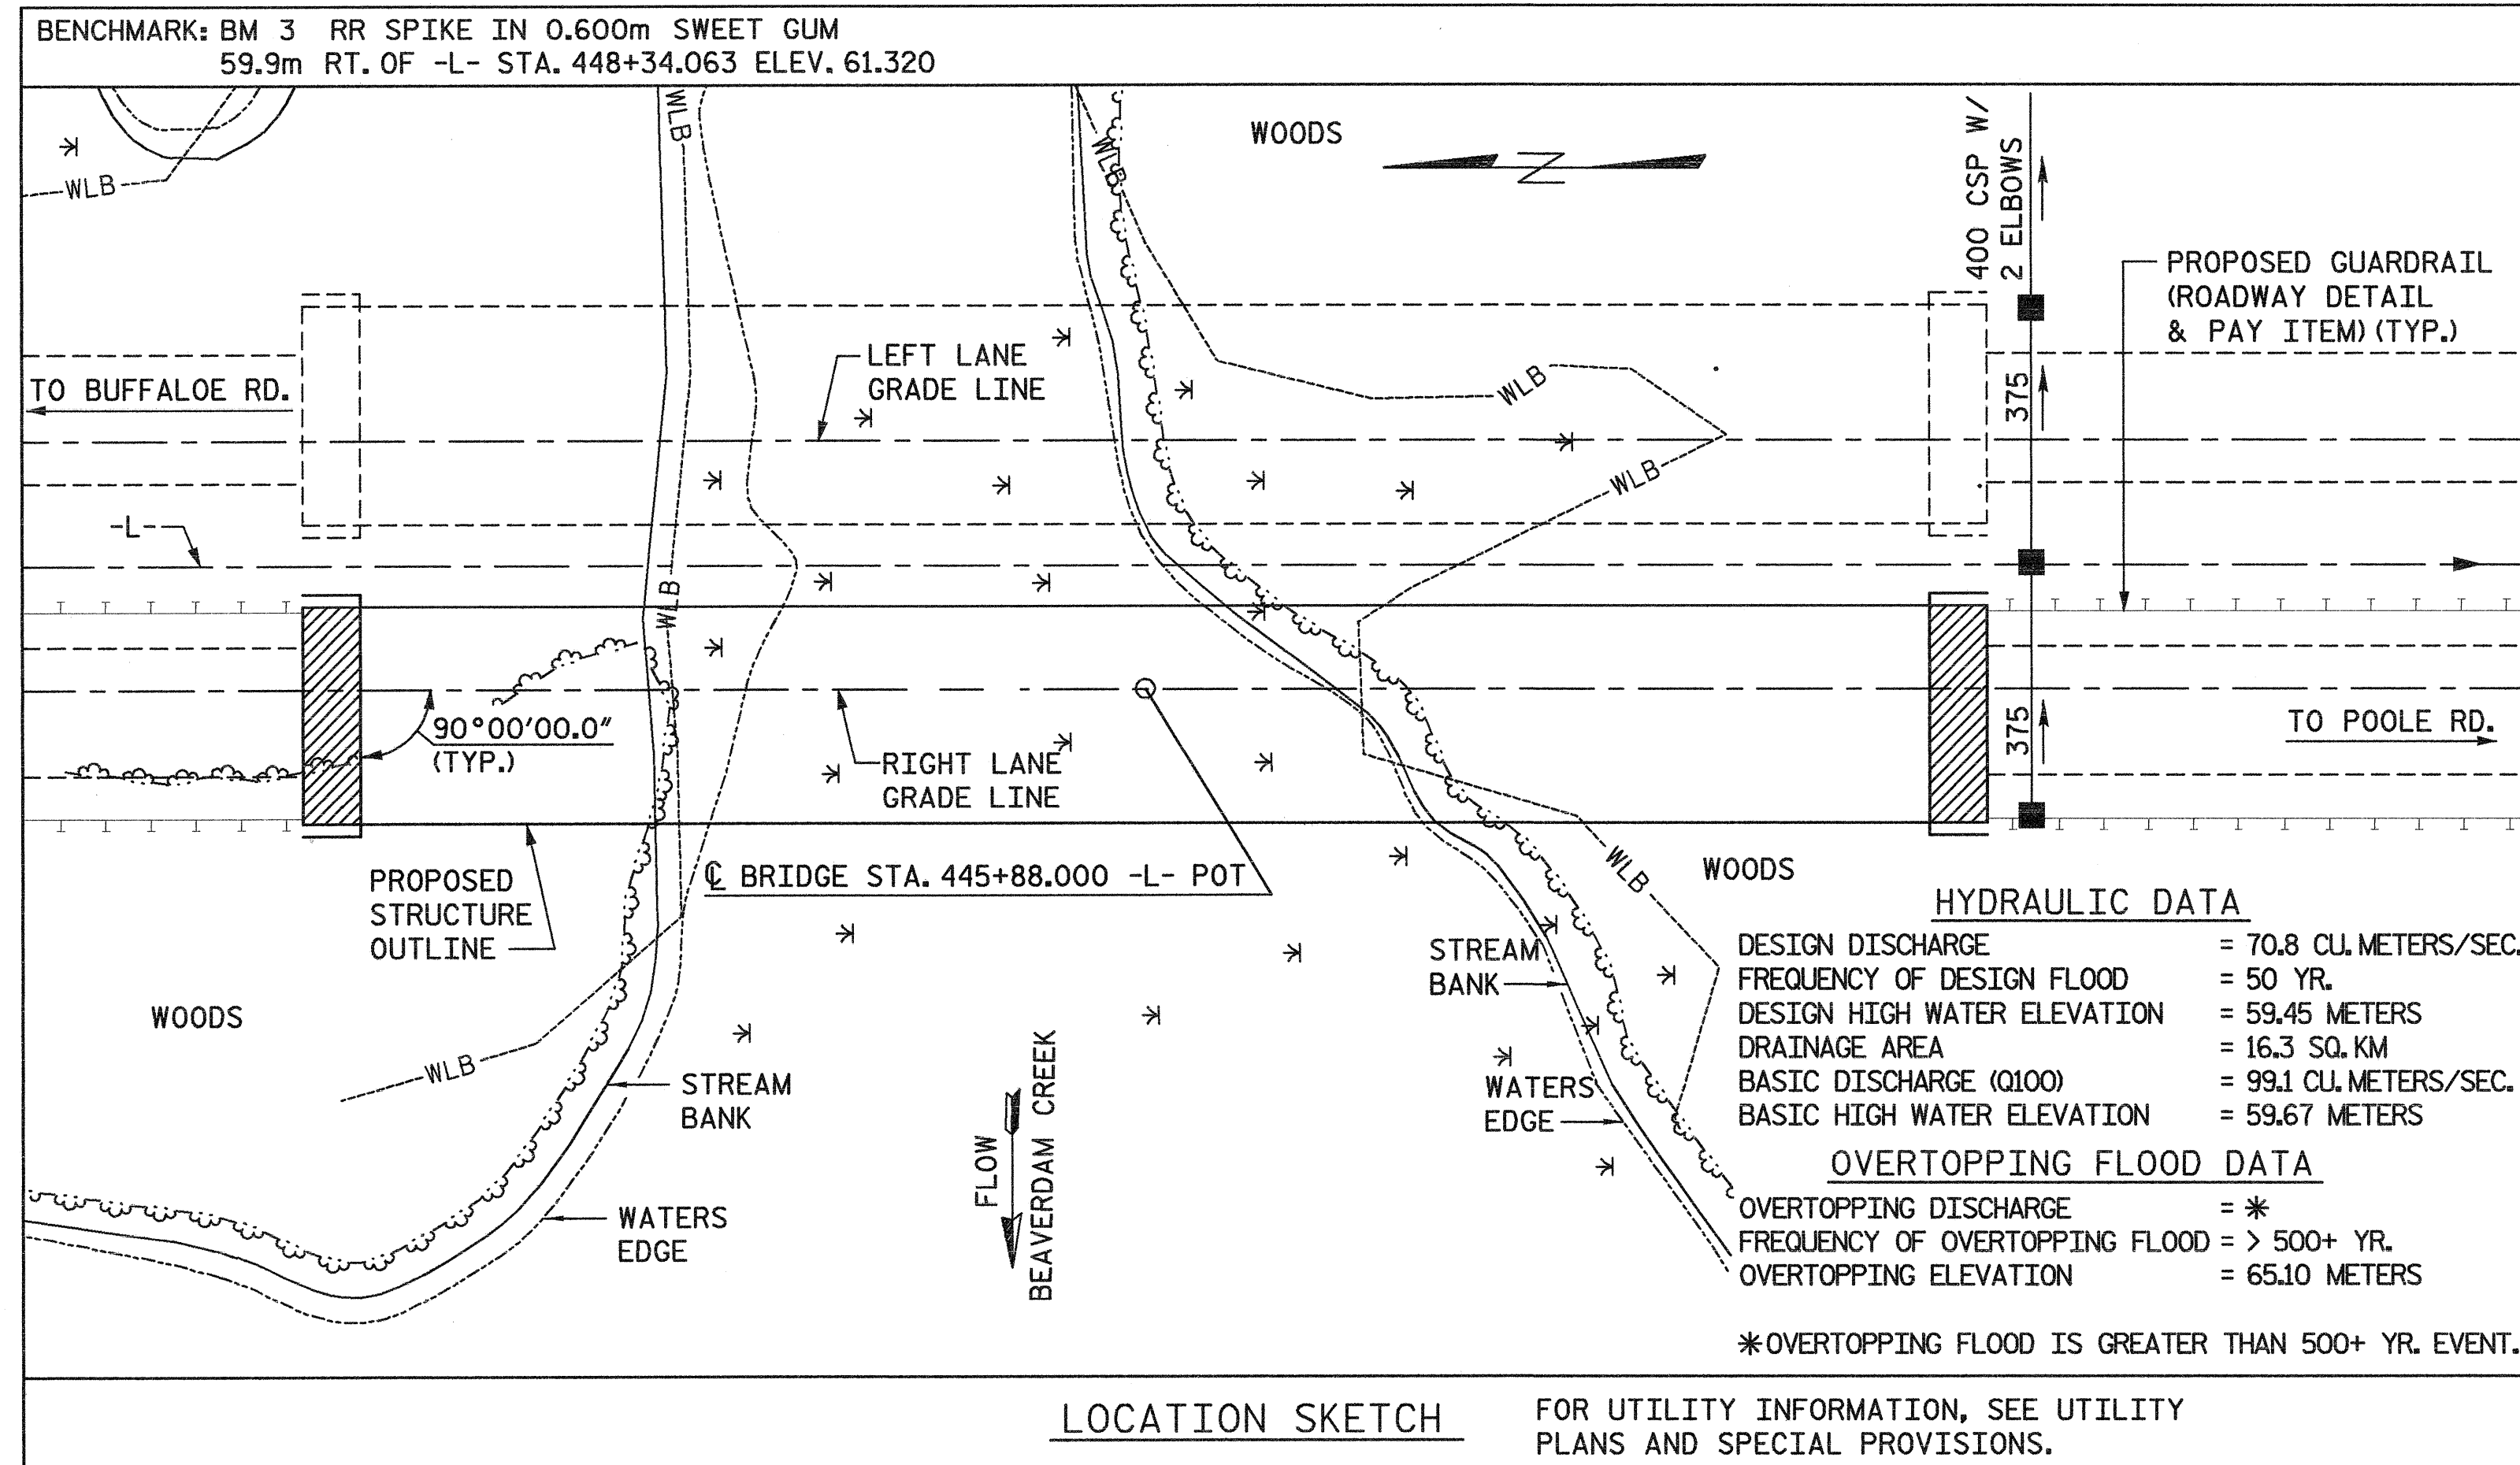

### NOTES

ASSUMED LIVE LOAD = MS18 OR ALTERNATE LOADING.

THIS BRIDGE HAS BEEN DESIGNED IN ACCORDANCE WITH THE REQUIREMENTS OF THE STANDARD SPECIFICATIONS FOR SEISMIC DESIGN OF HIGHWAY BRIDGES FOR SEISMIC PERFORMANCE CATEGORY A.

ALL DIMENSIONS ARE IN MILLIMETERS UNLESS OTHERWISE NOTED.

ALL ELEVATIONS ARE IN METERS.

THIS BRIDGE HAS BEEN DESIGNED BY THE STRENGTH DESIGN METHOD AS SPECIFIED IN AASHTO STANDARD SPECIFICATIONS.

FOR OTHER DESIGN DATA AND GENERAL NOTES, SEE SHEET SNSM.

THE CONTRACTOR SHALL PROVIDE INDEPENDENT ASSURANCE SAMPLES OF REINFORCING STEEL AS FOLLOWS: FOR PROJECTS REQUIRING UP TO 360,000 kg OF REINFORCING STEEL, ONE 760mm SAMPLE OF EACH SIZE BAR USED, AND FOR PROJECTS REQUIRING OVER 360,000 kg OF REINFORCING STEEL, TWO 760mm SAMPLES OF EACH SIZE BAR USED. THE BARS FROM WHICH THE SAMPLES ARE TAKEN MUST THEN BE SPliced WITH REPLACEMENT BARS OF THE SIZE AND LENGTH OF THE SAMPLE, PLUS A MINIMUM LAP SPlice OF THIRTY BAR DIAMETERS.

THE CLASS AA CONCRETE IN THE BRIDGE DECK SHALL CONTAIN FLY ASH OR GROUND GRANULATED BLAST FURNACE SLAG AT THE SUBSTITUTION RATE SPECIFIED IN ARTICLE 1024-1 AND IN ACCORDANCE WITH ARTICLES 1024-5 AND 1024-6 OF THE STANDARD SPECIFICATIONS. NO PAYMENT WILL BE MADE FOR THIS SUBSTITUTION AS IT IS CONSIDERED INCIDENTAL TO THE COST OF THE REINFORCED CONCRETE DECK SLAB.

THIS STRUCTURE HAS BEEN DESIGNED IN ACCORDANCE WITH HEC 18, "EVALUATING SCOUR AT BRIDGES", NOVEMBER, 1995.

FOR METRIC STRUCTURAL STEEL, SEE SPECIAL PROVISIONS.

THE DRILLED PIERS FOR BENTS NO.1, 2 AND 3 HAVE BEEN DESIGNED FOR BOTH SKIN FRICTION AND TIP BEARING. THE REQUIRED TIP BEARING CAPACITY IS 1915 kPa.

THE REQUIRED TIP BEARING CAPACITY AT BENTS NO.1, 2 AND 3 SHALL BE VERIFIED.

THE DRILLED PIERS FOR BENTS NO.1, 2 AND 3 HAVE BEEN DESIGNED FOR AN APPLIED LOAD OF 2,510 kN EACH AT THE TOP OF THE COLUMN.

PERMANENT STEEL CASING IS REQUIRED FOR THE DRILLED PIERS AT BENT NO.1 AND THE CASINGS SHALL NOT EXTEND BELOW ELEVATION 53.0m WITHOUT THE ENGINEER'S PERMISSION.

PERMANENT STEEL CASING IS REQUIRED FOR THE DRILLED PIERS AT BENT NO.2 AND THE CASINGS SHALL NOT EXTEND BELOW ELEVATION 53.5m WITHOUT THE ENGINEER'S PERMISSION.

PERMANENT STEEL CASING IS NOT REQUIRED FOR THE DRILLED PIERS AT BENT NO.3.

FOR PERMANENT STEEL CASING, SEE SPECIAL PROVISIONS FOR DRILLED PIERS.

DRILLED PIERS AT BENT NO.1 SHALL EXTEND TO ELEVATIONS NO HIGHER THAN THE FOLLOWING LISTED ELEVATIONS FROM LEFT TO RIGHT: SHAFT 1 = 52.0m, SHAFT 2 = 52.0m, SHAFT 3 = 50.0m, SHAFT 4 = 50.0m AND SATISFY THE REQUIRED TIP BEARING CAPACITY.

DRILLED PIERS AT BENT 2 SHALL EXTEND TO AN ELEVATION NO HIGHER THAN 47.5m FOR ALL SHAFTS AND SATISFY THE REQUIRED TIP BEARING CAPACITY.

DRILLED PIERS AT BENT 3 SHALL EXTEND TO ELEVATIONS NO HIGHER THAN THE FOLLOWING LISTED ELEVATIONS FROM LEFT TO RIGHT : SHAFT 1 = 53.0m, SHAFT 2 = 52.0m, SHAFT 3 = 50.0m, SHAFT 4 = 47.0m AND SATISFY THE REQUIRED TIP BEARING CAPACITY.

THE SCOUR CRITICAL ELEVATIONS FOR BENT 1 ARE 53.0. THESE ELEVATIONS ARE FOR USE BY MAINTENANCE FORCES TO MONITOR POSSIBLE SCOUR PROBLEMS DURING THE LIFE OF THE STRUCTURE.

THE SCOUR CRITICAL ELEVATIONS FOR BENT 2 ARE THE FOLLOWING LISTED ELEVATIONS FROM LEFT TO RIGHT: SHAFT 1 = 49.5m, SHAFT 2 = 50.5m, SHAFT 3 = 51.5m AND SHAFT 4 = 52.5m. THE SCOUR CRITICAL ELEVATIONS ARE USED BY MAINTENANCE FORCES TO MONITOR POSSIBLE SCOUR PROBLEMS DURING THE LIFE OF THE STRUCTURE.

THE SCOUR CRITICAL ELEVATIONS FOR BENT 3 ARE THE FOLLOWING LISTED ELEVATIONS FROM LEFT TO RIGHT: SHAFT 1 = 55.0m, SHAFT 2 = 54.0m, SHAFT 3 = 53.0m AND SHAFT 4 = 52.0m. THE SCOUR CRITICAL ELEVATIONS ARE USED BY MAINTENANCE FORCES TO MONITOR POSSIBLE SCOUR PROBLEMS DURING THE LIFE OF THE STRUCTURE.

FOR DRILLED PIERS, SEE SPECIAL PROVISIONS.

SPT TESTING IS NOT REQUIRED TO DETERMINE THE TIP BEARING CAPACITY OF THE DRILLED PIERS AT BENTS NO.1, 2 AND 3.

SLURRY CONSTRUCTION SHALL NOT BE USED FOR THIS PROJECT.

SID INSPECTIONS ARE NOT REQUIRED TO DETERMINE THE BOTTOM CLEANLINESS OF THE DRILLED PIERS AT BENTS NO.1, 2 AND 3.

CSL TUBES ARE REQUIRED AND CSL TESTING MAY BE REQUIRED FOR THE DRILLED PIERS AT BENTS NO.1, 2 AND 3. SEE SPECIAL PROVISIONS FOR CROSSHOLE SONIC LOGGING.

THE CONTRACTOR SHALL OBSERVE A ONE-MONTH WAITING PERIOD BEFORE BEGINNING ANY WORK FOR END BENT CONSTRUCTION AFTER COMPLETION OF THE EMBANKMENT AT EACH END BENT. THE CONTRACTOR MAY BEGIN THE REINFORCED BRIDGE APPROACH FILL CONSTRUCTION AFTER COMPLETION OF END BENT INCLUDING WINGWALLS.

PILES FOR END BENTS NO.1 AND 2 SHALL BE DRIVEN TO A MINIMUM BEARING CAPACITY OF 620 kN EACH.

WHEN DRIVING PILES, THE MAXIMUM BLOW COUNT SHALL NOT BE EXCEEDED.

FOR EROSION CONTROL MEASURES, SEE EROSION CONTROL PLANS.

FOR SUBMITTAL OF WORKING DRAWINGS, SEE SPECIAL PROVISIONS.

FOR FALSEWORK AND FORMWORK, SEE SPECIAL PROVISIONS.

NEEDLE BEAMS WILL NOT BE ALLOWED UNLESS OTHERWISE CALLED FOR ON THE PLANS OR APPROVED BY THE ENGINEER.

FOR WORK BRIDGE, SEE SPECIAL PROVISIONS FOR CONSTRUCTION, MAINTENANCE AND REMOVAL OF TEMPORARY ACCESS. FOR PAY ITEM FOR CONSTRUCTION, MAINTENANCE AND REMOVAL OF TEMPORARY ACCESS, SEE LEFT LANE.

FOR ELECTRICAL CONDUIT SYSTEM, SEE SPECIAL PROVISIONS.

TOTAL BILL OF MATERIAL										
	CONSTRUCTION, MAINTENANCE & REMOVAL OF TEMPORARY ACCESS	1372mm DIA. DRILLED PIERS NOT IN SOIL	1372mm DIA. DRILLED PIERS IN SOIL	PERMANENT STEEL CASING FOR 1372mm DIA. DRILLED PIERS	CROSSHOLE SONIC LOGGING	CSL TUBES	REINFORCED CONCRETE DECK SLAB	GROOVING BRIDGE FLOORS	CLASS A CONCRETE	BRIDGE APPROACH SLABS
	LUMP SUM	LIN. METERS	LIN. METERS	LIN. METERS	EACH	LIN. METERS	SQ. METERS	SQ. METERS	CU. METERS	LUMP SUM
SUPERSTRUCTURE							2,418.7	2,331.6		
END BENT 1									47.5	LUMP SUM
BENT 1	LUMP SUM	10.5	19.7	22.2	1	133.0			70.0	
BENT 2	LUMP SUM	11.0	33.2	20.2	1	189.0			74.4	
BENT 3	LUMP SUM	13.0	21.8		1	151.4			75.8	
END BENT 2									48.8	LUMP SUM
TOTAL	LUMP SUM	34.5	74.7	42.4	3	473.4	2,418.7	2,331.6	316.5	LUMP SUM

TOTAL BILL OF MATERIAL											
	REINFORCING STEEL	SPIRAL COLUMN REINFORCING STEEL	MODIFIED 1829mm PRESTRESSED CONCRETE GIRDERS		HP360x108 STEEL PILES		CONCRETE BARRIER RAIL	PLAIN RIP RAP CLASS II (600mm THICK)	FILTER FABRIC FOR DRAINAGE	ELASTOMERIC BEARINGS	EXPANSION JOINT SEALS
	Kg	Kg	NO.	LIN. METERS	NO.	LIN. METERS	LIN. METERS	METRIC TONS	SQ. METERS	LUMP SUM	LUMP SUM
SUPERSTRUCTURE			24	785.760			263.760			LUMP SUM	LUMP SUM
END BENT 1	4,512				20	140.0		415	420		
BENT 1	9,877	2,619									
BENT 2	11,563	3,396									
BENT 3	10,773	3,043									
END BENT 2	4,591				20	250.0		755	770		
TOTAL	41,316	9,058	24	785.760	40	390.0	263.760	1,170	1,190	LUMP SUM	LUMP SUM

PROJECT NO. R-2000G

WAKE COUNTY

STATION: 445+88.000 -L- POT

SHEET 3 OF 3

STATE OF NORTH CAROLINA  
DEPARTMENT OF TRANSPORTATION  
RALEIGH

GENERAL DRAWING  
FOR BRIDGE ON I-540 (RALEIGH OUTER LOOP) OVER BEAVERDAM CREEK BETWEEN SR 2217 & US-64

RIGHT LANE

REVISIONS						SHEET NO.
NO.	BY	DATE	NO.	BY	DATE	
1			3			8-71
2			4			145

Nallamala & Wilson, P.A.

1399 Ashleybrook Lane, Suite 130  
Winston-Salem, N.C. 27103-2918  
Ph: (336) 765-4651 Fax: (336) 765-6194

DWG. NO. 2101(2)RS-3

PROFESSIONAL SEAL  
NORTH CAROLINA  
ENGINEER  
S. B. Nallamala

DRAWN BY : WESLEY I. JONES, III DATE : 10/14/02  
CHECKED BY : DATE : 12-12-02



(-)0.3000% (+)2.8397%

PI STA. = 444+00.000  
ELEV. = 64.951  
VC = 200.000m  
-L- GRADE DATA

RIGHT LANE GRADE  
LINE EL. 68.408  
AT FILL FACE  
END BENT 1  
STA. 445+21.730 -L-

BEGIN FRONT SLOPE  
STA. 445+18.236 -L-  
RIGHT LANE GRADE  
LINE EL. 68.309

HP360x108  
STEEL PILES

APPROXIMATE  
EXISTING  
GROUNDLINE

480mm BERM  
(NORMAL TO CAP)  
300mm EARTH BERM  
(NORMAL TO CAP)

SLOPE 1.5 : 1  
(NORMAL TO CAP)

PLAIN RIP RAP  
CLASS II (TYP.)

EL. 60.8±

EL. 60.0±

TOP OF DRILLED  
PIERS EL. 58.550

HIGH WATER  
SURFACE  
EL. 59.4± (9/96)

EXP. EXP.

BENT 1

SPAN A

SPAN B

SPAN C

SPAN D

NORMAL WATER  
SURFACE  
EL. 58.25 (2-6-97)

FIX. FIX.

BENT 2

EL. 58.0±

TOP OF DRILLED  
PIERS EL. 59.200

EXP. EXP.

BENT 3

SLOPE 1.5 : 1  
(NORMAL TO CAP)

480mm BERM  
(NORMAL TO CAP)  
300mm EARTH BERM  
(NORMAL TO CAP)

HP360x108  
STEEL PILES

EL. 61.0±

EL. 60.5±

EL. 63.0±

EL. 64.6±

END BENT 2



RIGHT LANE GRADE  
LINE EL. 72.172  
AT FILL FACE  
END BENT 2  
STA. 446+54.270 -L-  
BEGIN FRONT SLOPE  
STA. 446+58.130 -L-  
RIGHT LANE GRADE  
LINE EL. 72.281

END BENT 1

### SECTION ALONG RIGHT LANE GRADE LINE

(BENTS ON SECTION AT RIGHT ANGLES TO BENTS)

132.540m TOTAL LENGTH OF BRIDGE FROM FILL FACE TO FILL FACE

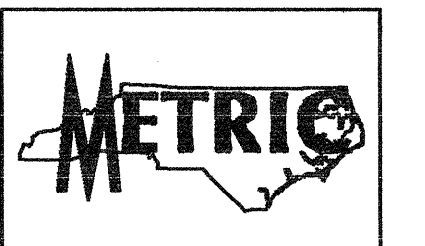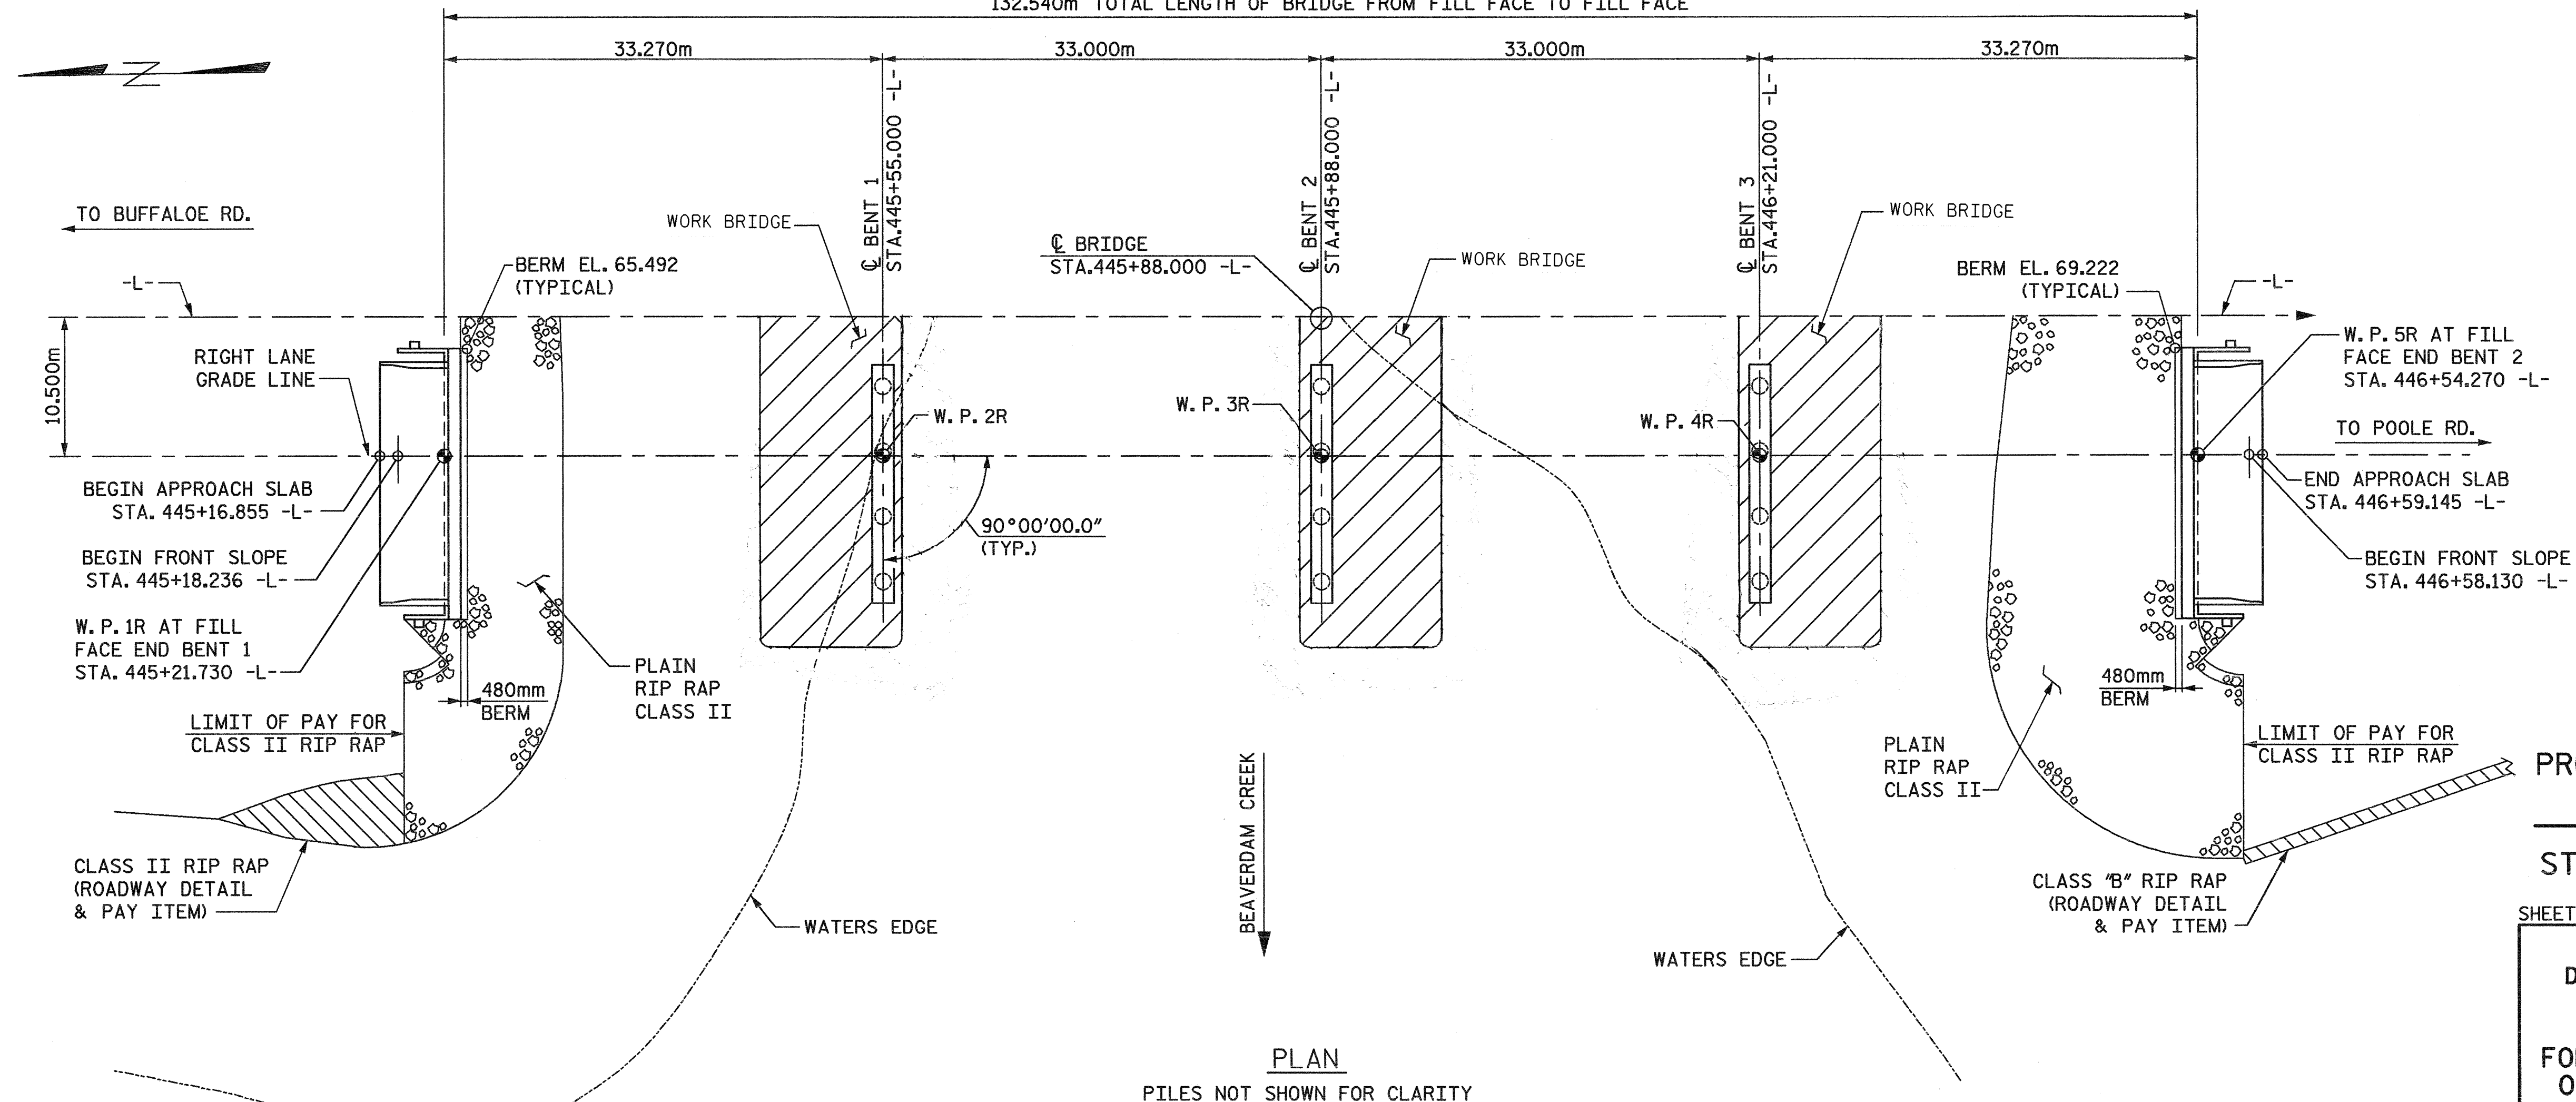

PROJECT NO. R-2000G  
WAKE COUNTY  
STATION: 445+88.000 -L- POT


SHEET 1 OF 2 BRIDGE NO. 1015

STATE OF NORTH CAROLINA  
DEPARTMENT OF TRANSPORTATION  
RALEIGH  
GENERAL DRAWING  
FOR BRIDGE ON I-540 (RALEIGH  
OUTER LOOP) OVER BEAVERDAM  
CREEK BETWEEN SR 2217 & US-64

RIGHT LANE

REVISIONS

NO.	BY	DATE	NO.	BY	DATE	SHEET NO.
1			3			145
2			4			

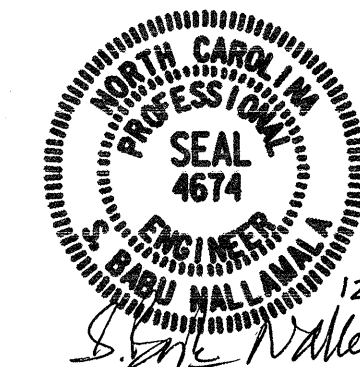

Nallamala & Wilson, P.A.  
1399 Ashleybrook Lane, Suite 130  
Winston-Salem, N.C. 27103-2918  
Ph: (336) 765-4651 Fax: (336) 765-6194  
DWG. NO. 2101(2)RS-1

DRAWN BY: WESLEY I. JONES, III DATE: 10/14/02  
CHECKED BY: [Signature] DATE: 12-12-02



(-)0.3000% (+)2.8397%

PI STA. = 444+00.000  
ELEV. = 64.951  
VC = 200.000m  
-L- GRADE DATA

LEFT LANE GRADE  
LINE EL. 68.408  
AT FILL FACE  
END BENT 1  
STA. 445+21.730 -L-

BEGIN FRONT SLOPE  
STA. 445+18.236 -L-  
LEFT LANE GRADE  
LINE EL. 68.309

EL. 61.2±  
EL. 61.0±

HP360x108  
STEEL PILES

EL. 61.3±

APPROXIMATE  
EXISTING  
GROUNDLINE

END BENT 1

SPAN A

SPAN B

SPAN C

SPAN D

LEFT LANE GRADE  
LINE EL. 72.172  
AT FILL FACE  
END BENT 2  
STA. 446+54.270 -L-

BEGIN FRONT SLOPE  
STA. 446+58.130 -L-  
LEFT LANE GRADE  
LINE EL. 72.281

SLOPE 1.5 : 1  
(NORMAL TO CAP)

480mm BERM  
(NORMAL TO CAP)  
300mm EARTH BERM  
(NORMAL TO CAP)

EXP. 450

EXP. 450

HIGH WATER  
EL. 59.4± (9/96)  
NORMAL WATER SURFACE  
EL. 58.25 (2-6-97)

FIX. FIX.

EL. 58.2±

EL. 56.4±

EL. 57.4±

EL. 56.8±

EL. 58.6±

EL. 59.2±

EL. 58.2±

EL. 56.4±

EL. 57.4±

EL. 56.8±

EL. 58.6±

EL. 59.2±

EL. 58.2±

EL. 56.4±

EL. 57.4±



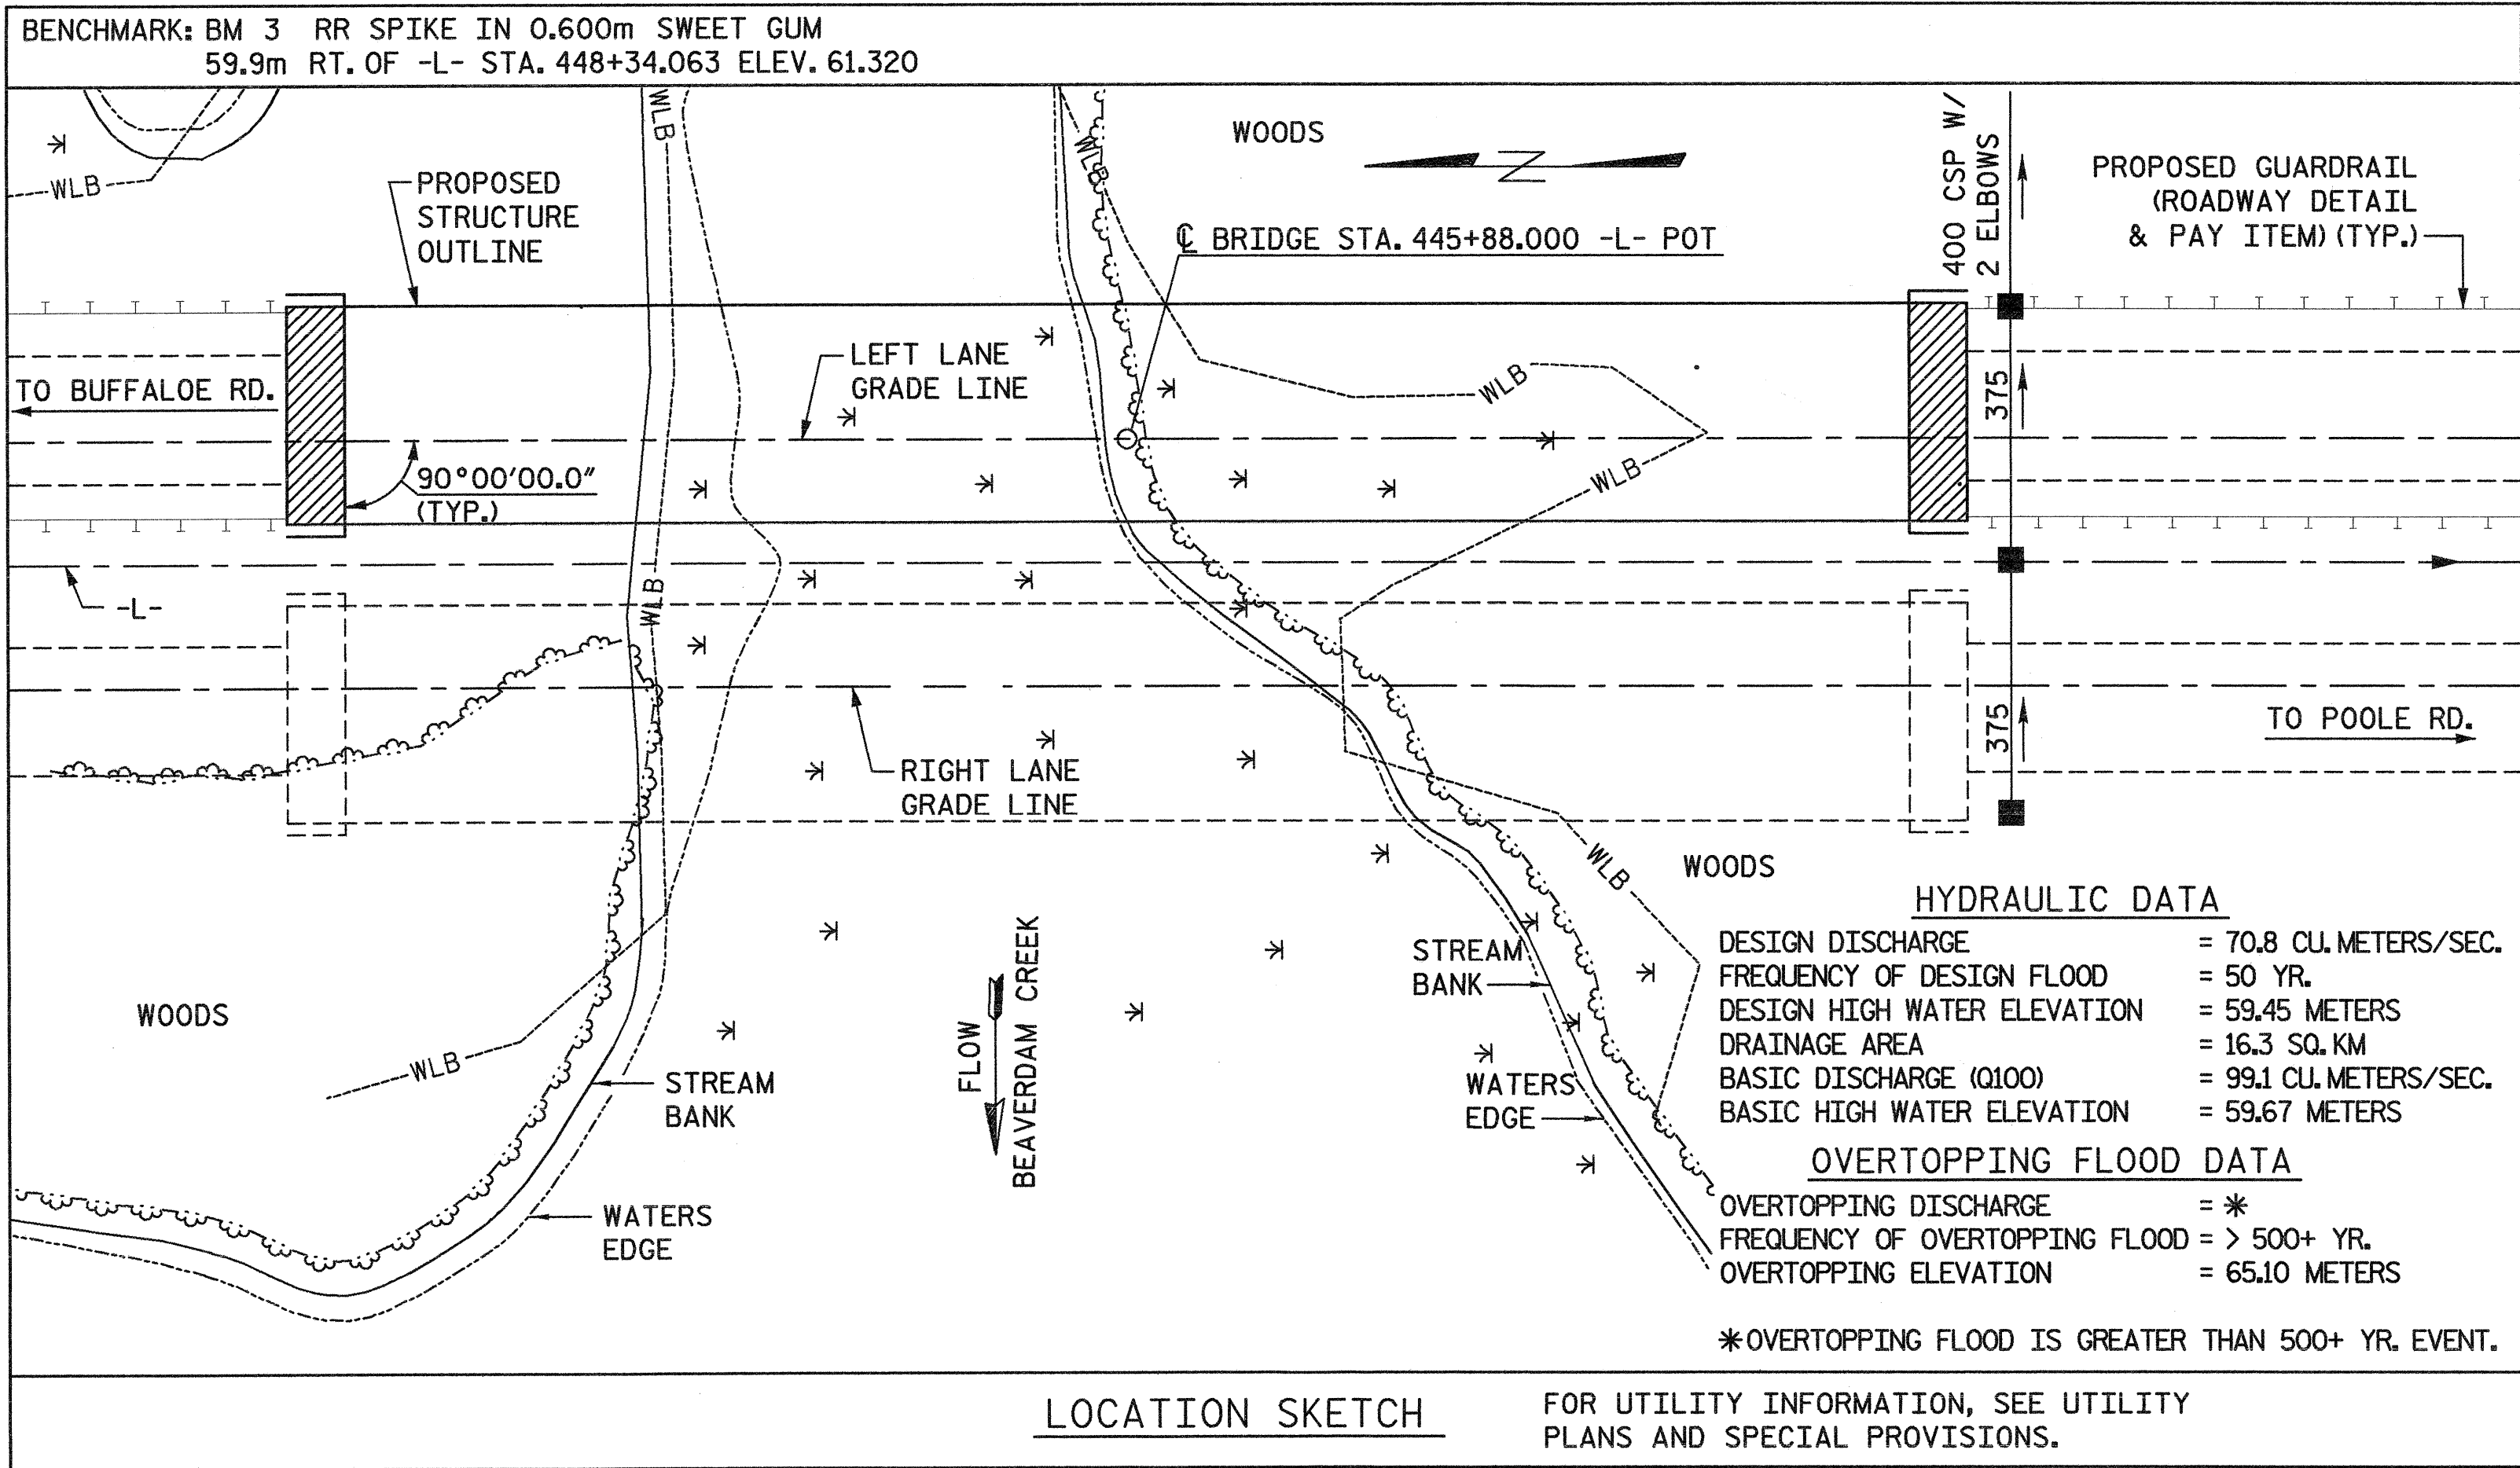

TOTAL BILL OF MATERIAL										
	CONSTRUCTION, MAINTENANCE & REMOVAL OF TEMPORARY ACCESS	1372mm DIA. DRILLED PIERS NOT IN SOIL	1372mm DIA. DRILLED PIERS IN SOIL	PERMANENT STEEL CASING FOR 1372mm DIA. DRILLED PIERS	CROSSHOLE SONIC LOGGING	CSL TUBES	REINFORCED CONCRETE DECK SLAB	GROOVING BRIDGE FLOORS	CLASS A CONCRETE	BRIDGE APPROACH SLABS
	LUMP SUM	LIN. METERS	LIN. METERS	LIN. METERS	EACH	LIN. METERS	SQ. METERS	SQ. METERS	CU. METERS	LUMP SUM
SUPERSTRUCTURE	---	---	---	---	---	---	2,418.7	2,331.6	---	---
END BENT 1	---	---	---	---	---	---	---	---	47.5	LUMP SUM
BENT 1	LUMP SUM	11.0	11.2	9.2	1	101.0	---	---	70.0	---
BENT 2	LUMP SUM	12.0	21.4	15.9	1	145.8	---	---	76.5	---
BENT 3	LUMP SUM	13.0	7.8	---	1	95.4	---	---	73.4	---
END BENT 2	---	---	---	---	---	---	---	---	48.8	LUMP SUM
TOTAL	LUMP SUM	36.0	40.4	25.1	3	342.2	2,418.7	2,331.6	316.2	LUMP SUM

TOTAL BILL OF MATERIAL											
	REINFORCING STEEL	SPIRAL COLUMN REINFORCING STEEL	MODIFIED I829mm PRESTRESSED CONCRETE GIRDERS		HP360x108 STEEL PILES		CONCRETE BARRIER RAIL	PLAIN RIP RAP CLASS II (600mm THICK)	FILTER FABRIC FOR DRAINAGE	ELASTOMERIC BEARINGS	EXPANSION JOINT SEALS
	Kg	Kg	NO.	LIN. METERS	NO.	LIN. METERS	LIN. METERS	METRIC TONS	SQ. METERS	LUMP SUM	LUMP SUM
SUPERSTRUCTURE	---	---	24	785.760	---	---	263.760	---	---	LUMP SUM	LUMP SUM
END BENT 1	4,512	---	---	---	20	150.0	---	350	360	---	---
BENT 1	9,118	2,274	---	---	---	---	---	---	---	---	---
BENT 2	10,708	3,013	---	---	---	---	---	---	---	---	---
BENT 3	9,255	2,347	---	---	---	---	---	---	---	---	---
END BENT 2	4,591	---	---	---	20	160.0	---	410	415	---	---
TOTAL	38,184	7,634	24	785.760	40	310.0	263.760	760	775	LUMP SUM	LUMP SUM

DRAWN BY : WESLEY L. JONES, III DATE : 09/12/02  
CHECKED BY : *Wesley L. Jones* DATE : 12-12-02

## NOTES

ASSUMED LIVE LOAD = MS18 OR ALTERNATE LOADING.

THIS BRIDGE HAS BEEN DESIGNED IN ACCORDANCE WITH THE REQUIREMENTS OF THE STANDARD SPECIFICATIONS FOR SEISMIC DESIGN OF HIGHWAY BRIDGES FOR SEISMIC PERFORMANCE CATEGORY A.

ALL DIMENSIONS ARE IN MILLIMETERS UNLESS OTHERWISE NOTED.

ALL ELEVATIONS ARE IN METERS.

THIS BRIDGE HAS BEEN DESIGNED BY THE STRENGTH DESIGN METHOD AS SPECIFIED IN AASHTO STANDARD SPECIFICATIONS.

FOR OTHER DESIGN DATA AND GENERAL NOTES, SEE SHEET SNSM.

THE CONTRACTOR SHALL PROVIDE INDEPENDENT ASSURANCE SAMPLES OF REINFORCING STEEL AS FOLLOWS: FOR PROJECTS REQUIRING UP TO 360,000 kg OF REINFORCING STEEL, ONE 760mm SAMPLE OF EACH SIZE BAR USED, AND FOR PROJECTS REQUIRING OVER 360,000 kg OF REINFORCING STEEL, TWO 760mm SAMPLES OF EACH SIZE BAR USED. THE BARS FROM WHICH THE SAMPLES ARE TAKEN MUST THEN BE SPliced WITH REPLACEMENT BARS OF THE SIZE AND LENGTH OF THE SAMPLE, PLUS A MINIMUM LAP SPLICE OF THIRTY BAR DIAMETERS.

THE CLASS AA CONCRETE IN THE BRIDGE DECK SHALL CONTAIN FLY ASH OR GROUND GRANULATED BLAST FURNACE SLAG AT THE SUBSTITUTION RATE SPECIFIED IN ARTICLE 1024-1 AND IN ACCORDANCE WITH ARTICLES 1024-5 AND 1024-6 OF THE STANDARD SPECIFICATIONS. NO PAYMENT WILL BE MADE FOR THIS SUBSTITUTION AS IT IS CONSIDERED INCIDENTAL TO THE COST OF THE REINFORCED CONCRETE DECK SLAB.

THIS STRUCTURE HAS BEEN DESIGNED IN ACCORDANCE WITH HEC 18, "EVALUATING SCOUR AT BRIDGES", NOVEMBER, 1995.

FOR METRIC STRUCTURAL STEEL, SEE SPECIAL PROVISIONS.

THE DRILLED PIERS FOR BENTS NO.1, 2 AND 3 HAVE BEEN DESIGNED FOR BOTH SKIN FRICTION AND TIP BEARING. THE REQUIRED TIP BEARING CAPACITY IS 1915 kPa.

THE REQUIRED TIP BEARING CAPACITY AT BENTS NO.1, 2 AND 3 SHALL BE VERIFIED.

THE DRILLED PIERS FOR BENTS NO.1, 2 AND 3 HAVE BEEN DESIGNED FOR AN APPLIED LOAD OF 2,510 kN EACH AT THE TOP OF THE COLUMN.

PERMANENT STEEL CASING IS REQUIRED FOR THE DRILLED PIERS AT BENT NO.1 AND THE CASINGS SHALL NOT EXTEND BELOW THE FOLLOWING LISTED ELEVATIONS FROM LEFT TO RIGHT : SHAFT 1 = 56.5m, SHAFT 2 = 56.5m, SHAFT 3 = 56.5m, SHAFT 4 = 55.5m WITHOUT THE ENGINEER'S PERMISSION.

PERMANENT STEEL CASING IS REQUIRED FOR THE DRILLED PIERS AT BENT NO.2 AND THE CASINGS SHALL NOT EXTEND BELOW THE FOLLOWING LISTED ELEVATIONS FROM LEFT TO RIGHT : SHAFT 1 = 54.5m, SHAFT 2 = 54.5m, SHAFT 3 = 55.0m, SHAFT 4 = 52.5m WITHOUT THE ENGINEER'S PERMISSION.

PERMANENT STEEL CASING IS NOT REQUIRED FOR THE DRILLED PIERS AT BENT NO.3.

FOR PERMANENT STEEL CASING, SEE SPECIAL PROVISIONS FOR DRILLED PIERS.

DRILLED PIERS AT BENT NO.1 SHALL EXTEND TO ELEVATIONS NO HIGHER THAN THE FOLLOWING LISTED ELEVATIONS FROM LEFT TO RIGHT: SHAFT 1 = 53.5m, SHAFT 2 = 53.5m, SHAFT 3 = 53.5m, SHAFT 4 = 51.5m AND SATISFY THE REQUIRED TIP BEARING CAPACITY.

DRILLED PIERS AT BENT 2 SHALL EXTEND TO ELEVATIONS NO HIGHER THAN THE FOLLOWING LISTED ELEVATIONS FROM LEFT TO RIGHT: SHAFT 1 = 51.0m, SHAFT 2 = 51.0m, SHAFT 3 = 49.0m, SHAFT 4 = 48.0m AND SATISFY THE REQUIRED TIP BEARING CAPACITY.

DRILLED PIERS AT BENT 3 SHALL EXTEND TO AN ELEVATION NO HIGHER THAN 54.5m FOR ALL SHAFTS AND SATISFY THE REQUIRED TIP BEARING CAPACITY.

THE SCOUR CRITICAL ELEVATION FOR BENT NO.1 IS 55.0. THESE ELEVATIONS ARE FOR USE BY MAINTENANCE FORCES TO MONITOR POSSIBLE SCOUR PROBLEMS DURING THE LIFE OF THE STRUCTURE.

THE SCOUR CRITICAL ELEVATIONS FOR BENT NO.2 ARE 53.0. THESE ELEVATIONS ARE USED BY MAINTENANCE FORCES TO MONITOR POSSIBLE SCOUR PROBLEMS DURING THE LIFE OF THE STRUCTURE.

THE SCOUR CRITICAL ELEVATIONS FOR BENT NO.3 ARE 56.5. THESE ELEVATIONS ARE USED BY MAINTENANCE FORCES TO MONITOR POSSIBLE SCOUR PROBLEMS DURING THE LIFE OF THE STRUCTURE.

FOR DRILLED PIERS, SEE SPECIAL PROVISIONS.

SPT TESTING IS NOT REQUIRED TO DETERMINE THE TIP BEARING CAPACITY OF THE DRILLED PIERS AT BENTS NO.1, 2 AND 3.

SLURRY CONSTRUCTION SHALL NOT BE USED FOR THIS PROJECT.

SID INSPECTIONS ARE NOT REQUIRED TO DETERMINE THE BOTTOM CLEANLINESS OF THE DRILLED PIERS AT BENTS NO.1, 2 AND 3.

CSL TUBES ARE REQUIRED AND CSL TESTING MAY BE REQUIRED FOR THE DRILLED PIERS AT BENTS NO.1, 2 AND 3. SEE SPECIAL PROVISIONS FOR CROSSHOLE SONIC LOGGING.

THE CONTRACTOR SHALL OBSERVE A ONE-MONTH WAITING PERIOD BEFORE BEGINNING ANY WORK FOR END BENT CONSTRUCTION AFTER COMPLETION OF THE EMBANKMENT AT EACH END BENT. THE CONTRACTOR MAY BEGIN THE REINFORCED BRIDGE APPROACH FILL CONSTRUCTION AFTER COMPLETION OF END BENT INCLUDING WINGWALLS.

PILES FOR END BENTS NO.1 AND 2 SHALL BE DRIVEN TO A MINIMUM BEARING CAPACITY OF 620 kN EACH.

WHEN DRIVING PILES, THE MAXIMUM BLOW COUNT SHALL NOT BE EXCEEDED.

FOR EROSION CONTROL MEASURES, SEE EROSION CONTROL PLANS.

FOR SUBMITTAL OF WORKING DRAWINGS, SEE SPECIAL PROVISIONS.

FOR FALSEWORK AND FORMWORK, SEE SPECIAL PROVISIONS.

NEEDLE BEAMS WILL NOT BE ALLOWED UNLESS OTHERWISE CALLED FOR ON THE PLANS OR APPROVED BY THE ENGINEER.

FOR WORK BRIDGE, SEE SPECIAL PROVISIONS FOR CONSTRUCTION, MAINTENANCE AND REMOVAL OF TEMPORARY ACCESS.

PROJECT NO. R-2000G  
WAKE COUNTY  
STATION: 445+88.000 -L- POT


SHEET 3 OF 3

STATE OF NORTH CAROLINA  
DEPARTMENT OF TRANSPORTATION  
RALEIGH

GENERAL DRAWING  
FOR BRIDGE ON I-540 (RALEIGH OUTER LOOP) OVER BEAVERDAM CREEK BETWEEN SR 2217 & US-64

LEFT LANE

REVISIONS						SHEET NO.
NO.	BY	DATE	NO.	BY	DATE	
1			3			S-37
2			4			

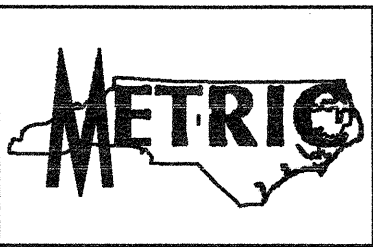

Nallamala & Wilson, P.A.

1399 Ashleybrook Lane, Suite 130  
Winston-Salem, N.C. 27103-2918  
Ph: (336) 765-4651 Fax: (336) 765-6194

DWG. NO. 2101(2)LS-3

